

Stone  
Gardner

MISSISSIPPI  
BOARD OF WATER COMMISSIONERS  
416 North State Street  
Jackson, Mississippi 39201

WATER WELL DRILLERS LOG

1-5 1982 Farnell Anderson Stone  
date well completed firm name county well located

LANDOWNER: <u>Ms Enoch Bond</u>	description of formations encountered	from	to
<u>Rt 3 Box 250</u> <u>Perkinston, Ms 39552</u> (mailing address)			
<b>WELL LOCATION:</b> sec. <u>14</u> T. <u>3</u> S. R. <u>11</u> E. W. <u>10</u> miles <u>SE</u> of <u>Wiggins</u> (distance) (direction) (nearest town)	<u>Top soil</u>	<u>0</u>	<u>3</u>
<b>WELL PURPOSE:</b> <u>Home</u> (home, irrigation, municipal, industrial)	<u>Sand</u>	<u>3</u>	<u>15</u>
<b>WELL COMPLETION DATA:</b>	<u>Clay</u>	<u>15</u>	<u>22</u>
(1) diameter (inches) <u>2"</u>	<u>Sand</u>	<u>22</u>	<u>36</u>
(2) total depth (feet) <u>36'</u>			
(3) static water level (feet) <u>30'</u> below top of ground.			
(4) casing <u>2"</u> <u>31'</u> (material) (depth)			
(size) If telescope see back.			
(5) screen <u>5'</u> <u>31'</u> (length) (depth to top)			
<u>2"</u> <u>PVC</u> (size) (material)			
(6) pump <u>1</u> <u>5</u> (HP) (yield gpm)			
<u>Electric</u> (type power)			
(7) electric log <u>NO</u> (yes or no)			
(organization running log)			
(8) how well bottom plugged <u>Capped</u>			
<b>DRILLERS REMARKS:</b>			


DEPT. OF NATURAL RESOURCES  
BUREAU OF LAND & WATER RESOURCES

MAR 12 1982

RECEIVED

If well telescopes please sketch and show depths.

GROUND LEVEL

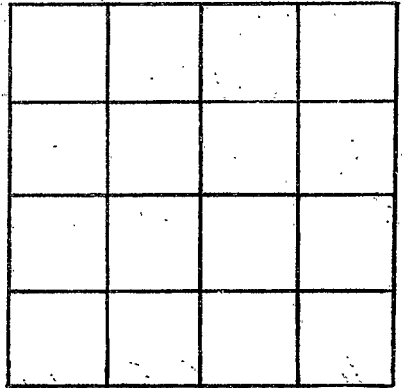

SECTION \_\_\_\_\_

Please indicate well location X.

ADDITIONAL INFORMATION

If more than one screen,  
show locations of each on sketch.