

MISSISSIPPI DEPARTMENT OF NATURAL RESOURCES

Bureau of Land and Water Resources

Southport Mall

P.O. Box 10631

Jackson, Mississippi 39209

WATER WELL DRILLERS LOG

Stone
G
2970

1-8
date well completed

82 Frank Price
firm name

Stone
county well located

LANDOWNER:
Abley Cooper

(mailing address)

description of formations encountered	from	to
Top Soil	0	3
Red Clay	3	21
Coarse Sand	21	35

WELL LOCATION:
sec. 8 T. 3 R. 11
2 miles NE of Park
(distance) (direction) (nearest town)

WELL PURPOSE: HOME
(home, irrigation, municipal, industrial)

WELL COMPLETION DATA:

(1) diameter (inches) 2"

(2) total depth (feet) 55

(3) static water level (feet) 20 below above top of ground.

(4) casing Plastic, 50'
(material) (depth)

_____ if telescope see back.
(size)

(5) screen 5", 50'
(length) (depth to top)

2", Plastic
(size) (material)

(6) pump 1 10
(HP) (yield gpm)

Elect
(type power)

(7) electric log no
(yes or no)

_____ (organization running log)

(8) how well bottom plugged Mark with valve

DRILLERS REMARKS:


DEPT. OF NATURAL RESOURCES
BUREAU OF LAND & WATER RESOURCES

FEB - 8 1962

RECEIVED

If well telescopes please sketch and show depths.

GROUND LEVEL

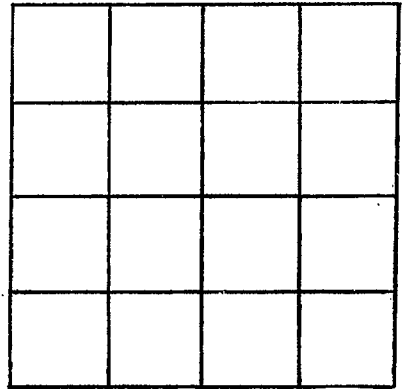

SECTION _____

Please indicate well location X.

ADDITIONAL INFORMATION

If more than one screen,
show locations of each on sketch.