

MISSISSIPPI DEPARTMENT OF NATURAL RESOURCES

Bureau of Land and Water Resources

Southport Mall

P.O. Box 10631

Jackson, Mississippi 39209

WATER WELL DRILLERS LOG

Stone
G 2002

2/4 1982 date well completed
 82 Lyman Well Co. firm name
 Stone Harrison county well located

LANDOWNER: <u>New Hope Baptist Church</u>	description of formations encountered	from	to
<u>McHenry Ms.</u>	<u>Red Clay & Sand</u>	<u>0</u>	<u>40</u>
(mailing address)	<u>Gumbo Clay</u>	<u>40</u>	<u>130</u>
WELL LOCATION:	<u>Blue Clay</u>	<u>130</u>	<u>180</u>
sec. <u>8</u> T. <u>3</u> N. R. <u>11</u> E.	<u>Sand</u>	<u>180</u>	<u>235</u>
<u>8</u> miles (distance)			
<u>NE</u> (direction)			
of <u>Pockinston</u> (nearest town)			
WELL PURPOSE: <u>Church</u> (home, irrigation, municipal, industrial)			
WELL COMPLETION DATA:			
(1) diameter (inches) <u>4"</u>			
(2) total depth (feet) <u>235</u>			
(3) static water level (feet) <u>127</u> (below/above top of ground)			
(4) casing <u>PVC 225</u> (material) (depth)			
<u>4"</u> (size) if telescope see back.			
(5) screen <u>10'</u> (length) <u>235</u> (depth to top)			
<u>4"</u> (size) <u>PVC</u> (material)			
(6) pump <u>1 1/2</u> (HP) <u>25</u> (yield gpm)			
<u>Elect.</u> (type power)			
(7) electric log <u>NO</u> (yes or no)			
<u>NO</u> (organization running log)			
(8) how well bottom plugged <u>Sand Shank</u>			
DRILLERS REMARKS:			


DEPT. OF NATURAL RESOURCES
 BUREAU OF LAND & WATER RESOURCES

APR 9 1982

RECEIVED

If well telescopes please sketch and show depths.

GROUND LEVEL

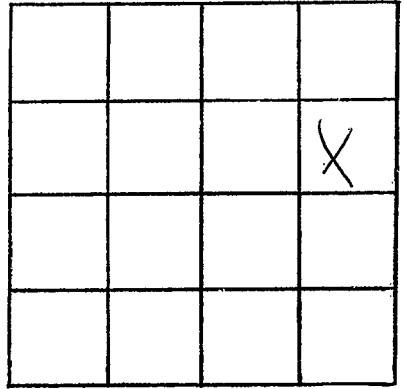

SECTION 8

Please indicate well location X.

ADDITIONAL INFORMATION

If more than one screen,
show locations of each on sketch.