

Stone
G 2076

MISSISSIPPI
BOARD OF WATER COMMISSIONERS
416 North State Street
Jackson, Mississippi 39201

WATER WELL DRILLERS LOG

May 20 1982 Parnee Anderson Stone
date well completed firm name county well located

LANDOWNER: Conner Cain
P.O. 717
Wiggins, MS
(mailing address)
WELL LOCATION:
sec 4 T 3 R 11
S W
6 miles SE of Wiggins
(distance) (direction) (nearest town)

description of formations encountered	from	to
<u>Top soil</u>	<u>0</u>	<u>2</u>
<u>clay</u>	<u>2</u>	<u>16</u>
<u>sand</u>	<u>16</u>	<u>42</u>
<u>clay</u>	<u>42</u>	<u>51</u>
<u>sand</u>	<u>51</u>	<u>84</u>

WELL PURPOSE: Home
(home, irrigation, municipal, industrial)

WELL COMPLETION DATA:
(1) diameter (inches) 2"
(2) total depth (feet) 84'
(3) static water level (feet) 55' below above top of ground.
(4) casing PVC
(material) (depth)
(size) if telescope see back.
(5) screen 5' 79'
(length) (depth to top)
2" PVC
(size) (material)
(6) pump 1 12
(HP) (yield gpm)
Electric
(type power)
(7) electric log NO
(yes or no)
(organization running log)
(8) how well bottom plugged Capped

DEPT. OF NATURAL RESOURCES
BUREAU OF LAND & WATER RESOURCES


JUN -9 1982

RECEIVED

DRILLERS REMARKS:

If well telescopes please sketch and show depths.

GROUND LEVEL

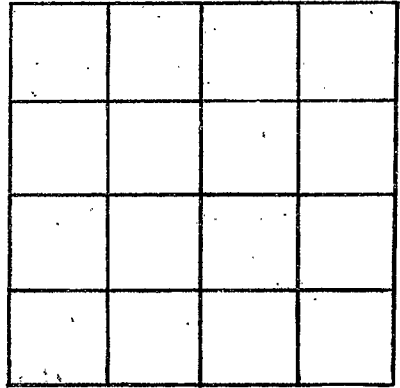

SECTION _____

Please indicate well location X.

ADDITIONAL INFORMATION

If more than one screen,
show locations of each on sketch.