

Stone
G207

MISSISSIPPI
BOARD OF WATER COMMISSIONERS
416 North State Street
Jackson, Mississippi 39201

WATER WELL DRILLERS LOG

June 28 1982 Farnell Anderson Stone
date well completed firm name county well located

LANDOWNER: <u>Farnell Anderson Stone</u>	description of formations encountered	from	to
<u>Ht 3</u>	<u>top soil</u>	<u>0</u>	<u>2</u>
<u>Perkinston, Ms</u>	<u>clay</u>	<u>2</u>	<u>17</u>
(mailing address)	<u>sand</u>	<u>12</u>	<u>32</u>
WELL LOCATION:	<u>clay</u>	<u>32</u>	<u>51</u>
sec <u>33</u> T <u>3</u> R <u>11</u> E	<u>sand</u>	<u>51</u>	<u>70</u>
7 miles S.E. of <u>Perkinston</u>			
(distance) (direction) (nearest town)			
WELL PURPOSE: <u>home</u> (home, irrigation, municipal, industrial)			
WELL COMPLETION DATA:			
(1) diameter (inches) <u>2"</u>			
(2) total depth (feet) <u>70'</u>			
(3) static water level (feet) <u>60'</u> below top of ground.			
(4) casing <u>PVC</u> (material) (depth)			
(size) If telescope see back.			
(5) screen <u>5'</u> <u>65'</u> (length) (depth to top)			
(size) <u>2"</u> <u>PVC</u> (material)			
(6) pump <u>1</u> <u>9</u> (HP) (yield gpm)			
(type power) <u>Electric</u>			
(7) electric log <u>NO</u> (yes or no)			
(organization running log)			
(8) how well bottom plugged <u>Capped</u>			
DRILLERS REMARKS:			


DEPT. OF NATURAL RESOURCES
BUREAU OF LAND & WATER RESOURCES

SEP 21 1982

RECEIVED

If well telescopes please sketch and show depths.

GROUND LEVEL

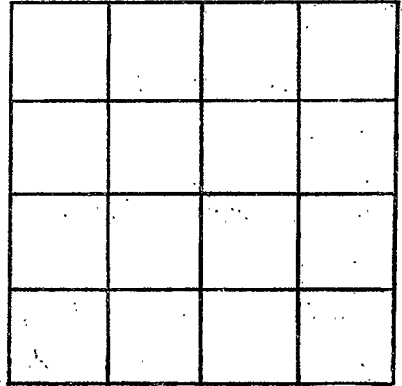

SECTION _____

Please indicate well location X.

ADDITIONAL INFORMATION

If more than one screen, show locations of each on sketch.