

Stone
G 2078

MISSISSIPPI
 BOARD OF WATER COMMISSIONERS
 416 North State Street
 Jackson, Mississippi 39201

WATER WELL DRILLERS LOG

Aug 6 1982 Farnell Anderson Stone
 date well completed firm name county well located

LANDOWNER: Faul Dillon
Rt 3
Perkinston, Ms
 (mailing address)

description of formations encountered	from	to
<u>top soil</u>	<u>0</u>	<u>2</u>
<u>Clay</u>	<u>2</u>	<u>26</u>
<u>sand</u>	<u>26</u>	<u>48</u>
<u>Clay</u>	<u>48</u>	<u>70</u>
<u>sand</u>	<u>70</u>	<u>102</u>

WELL LOCATION:
 sec 6 T 3 N R 11 E
 S W
5 miles S of Wiggins
 (distance) (direction) (nearest town)

WELL PURPOSE: Home
 (home, irrigation, municipal, industrial)

- WELL COMPLETION DATA:
- (1) diameter (inches) 2"
 - (2) total depth (feet) 102"
 - (3) static water level (feet) 50" below top of ground.
 - (4) casing P.V.C. (material), (depth)
 (size) if telescope see back.
 - (5) screen 5' (length), 99' (depth to top)
2" (size), P.V.C. (material)
 - (6) pump 1 (HP), 17 (yield gpm)
Electric (type power)
 - (7) electric log NO (yes or no)
 (organization running log)
 - (8) how well bottom plugged Capped

DRILLERS REMARKS:


DEPT. OF NATURAL RESOURCES
 BUREAU OF LAND & WATER RESOURCES

SEP 21 1982

RECEIVED

If well telescopes please sketch and show depths.

GROUND LEVEL

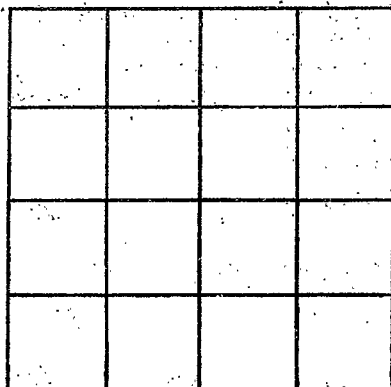

SECTION _____

Please indicate well location X.

ADDITIONAL INFORMATION

If more than one screen,
show locations of each on sketch.