

MISSISSIPPI DEPARTMENT OF NATURAL RESOURCES

Bureau of Land and Water Resources

Southport Mall

P.O. Box 10631

Jackson, Mississippi 39209

WATER WELL DRILLERS LOG

Stone
G
2081

2-8 1983 Frank Price Stone
date well completed firm name county well located

LANDOWNER:	description of formations encountered	from	to
<u>Kent Hatten</u>	<u>Top Soil</u>	<u>0</u>	<u>3</u>
(mailing address)	<u>Red Clay</u>	<u>3</u>	<u>25</u>
WELL LOCATION:	<u>Fine Sand</u>	<u>25</u>	<u>100</u>
sec. <u>1</u> T. <u>3</u> R. <u>11</u>	<u>Course Sand</u>	<u>100</u>	<u>114</u>
<u>S</u> <u>W</u> <u>BIG LEVEL</u>			
(distance) miles (direction) of (nearest town)			
WELL PURPOSE: <u>HOME</u>			
(home, irrigation, municipal, industrial)			
WELL COMPLETION DATA:			
(1) diameter (inches) <u>2"</u>			
(2) total depth (feet) <u>114'</u>			
(3) static water level (feet) <u>38</u> below above top of ground.			
(4) casing <u>Plastic</u> , <u>99'</u> (material) (depth)			
(size) If telescope see back.			
(5) screen <u>5"</u> , <u>99'</u> (length) (depth to top)			
<u>3"</u> , <u>PVC</u> (size) (material)			
(6) pump <u>1</u> <u>10</u> (HP) (yield gpm)			
<u>Elect</u> (type power)			
(7) electric log <u>no</u> (yes or no)			
(organization running log)			
(8) how well bottom plugged <u>B.W.V.</u>			
DRILLERS REMARKS:			


DEPT. OF NATURAL RESOURCES
BUREAU OF LAND & WATER RESOURCES

MAR - 9 1983

RECEIVED

If well telescopes please sketch and show depths.

GROUND LEVEL

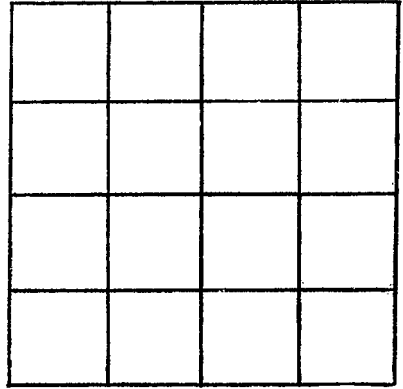

SECTION _____

Please indicate well location X.

ADDITIONAL INFORMATION

If more than one screen,
show locations of each on sketch.