

MISSISSIPPI DEPARTMENT OF NATURAL RESOURCES

Bureau of Land and Water Resources

Southport Mall

P.O. Box 10631

Jackson, Mississippi 39209

WATER WELL DRILLERS LOG

Stone  
G  
2082

7-12 1983  
 date well completed

Frank Price  
 firm name

Stone  
 county well located

LANDOWNER:  
Brad Stromme  
 (mailing address)  
 WELL LOCATION:  
 sec. 1 T. 3 S. R. 11 E.  
Big Level  
 miles (distance) (direction) of (nearest town)

description of formations encountered	from	to
<u>Top Soil</u>	<u>0</u>	<u>3</u>
<u>Sandy clay</u>	<u>3</u>	<u>25</u>
<u>Thin Sand</u>	<u>25</u>	<u>75</u>
<u>Course Sand</u>	<u>75</u>	<u>105</u>

WELL PURPOSE: HOME  
 (home, irrigation, municipal, industrial)

WELL COMPLETION DATA:  
 (1) diameter (inches) 2"  
 (2) total depth (feet) 105'  
 (3) static water level (feet) 42' below top of ground.  
 (4) casing Plastic, 100'  
 (material) (depth)  
 (size) if telescope see back.  
 (5) screen 5', 100'  
 (length) (depth to top)  
2", Plastic  
 (size) (material)  
 (6) pump 1 10  
 (HP) (yield gpm)  
Elect  
 (type power)  
 (7) electric log no  
 (yes or no)  
 (organization running log)

(8) how well bottom plugged  
B.W.V.

DRILLERS REMARKS:


DEPT. OF NATURAL RESOURCES  
 BUREAU OF LAND & WATER RESOURCES

SEP 12 1983

RECEIVED

If well telescopes please sketch and show depths.

GROUND LEVEL

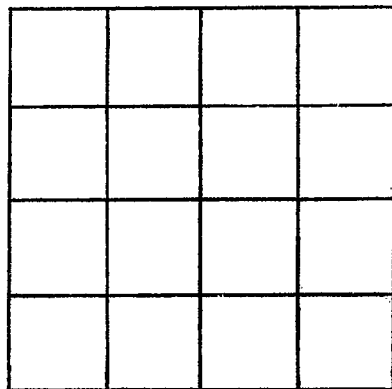

SECTION \_\_\_\_\_

Please indicate well location X.

ADDITIONAL INFORMATION

If more than one screen, show locations of each on sketch.