

MISSISSIPPI DEPARTMENT OF NATURAL RESOURCES

Bureau of Land and Water Resources

Southport Mall

P.O. Box 10631

Jackson, Mississippi 39209

WATER WELL DRILLERS LOG

Stone
G 2084

2/2/1984 date well completed Bradley Pump Sew. Inc. firm name Stone county well located

LANDOWNER: Richard Sparkling
Rt. 3, Box 56 A
Perkinston, Ms. 39573
(mailing address)

description of formations encountered	from	to
	<u>red clay</u>	<u>0</u>
<u>red sand + clay</u>	<u>20</u>	<u>40</u>
<u>gravel</u>	<u>40</u>	<u>60</u>
<u>sand</u>	<u>60</u>	<u>80</u>
<u>clay</u>	<u>80</u>	<u>120</u>
<u>clay</u>	<u>120</u>	<u>160</u>
<u>clay</u>	<u>160</u>	<u>240</u>
<u>brown sand</u>	<u>240</u>	<u>300</u>

WELL LOCATION:
sec. 19 T. 3 S. R. 11 E. W.
2 miles (distance) So. (direction) of Perkinston (nearest town)

WELL PURPOSE: home
(home, irrigation, municipal, industrial)

- WELL COMPLETION DATA:
- (1) diameter (inches) 4 X 2
 - (2) total depth (feet) 300
 - (3) static water level (feet) 150 below top of ground.
 - (4) casing PVC (material), 290 (depth)
4 X 2 (size) if telescope see back.
 - (5) screen 10' (length), 290 (depth to top)
2" (size), PVC underbar (material)
 - (6) pump 1 (HP), 12 (yield gpm)
230 V (type power)
 - (7) electric log no (yes or no)
(organization running log)
 - (8) how well bottom plugged PVC
sandspark

DRILLERS REMARKS: no
tail pipe

DEPT. OF NATURAL RESOURCES
BUREAU OF LAND & WATER RESOURCES
RECEIVED
FEB 10 1984


If well telescopes please sketch and show depths.

GROUND LEVEL

280'-4"
PVC sch.
40

10'-2" PVC
sch. 40

10' PVC
screen
underbar

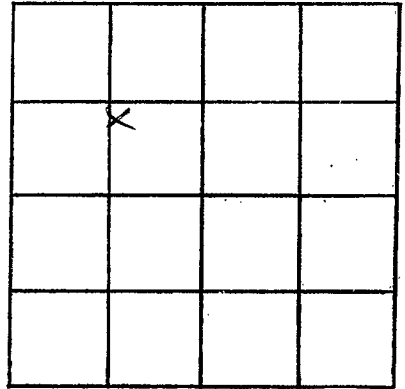

SECTION 19

Please indicate well location X.

ADDITIONAL INFORMATION

If more than one screen,
show locations of each on sketch.