

MISSISSIPPI DEPARTMENT OF NATURAL RESOURCES

Bureau of Land and Water Resources

Southport Mall

P.O. Box 10631

Jackson, Mississippi 39209

WATER WELL DRILLERS LOG

Stone
G
2085

1-26 1984 Frank Purie Stone  
 date well completed firm name county well located

LANDOWNER:  
 Earl R Pennington  
 (mailing address)

description of formations encountered	from	to
Top Soil	0	3
Red Clay	3	28
Course Sand	28	65

WELL LOCATION:  
 sec 29 T 3 R 11  
 2 miles SE of Perk  
 (distance) (direction) (nearest town)

WELL PURPOSE: HOME  
 (home, irrigation, municipal, industrial)

WELL COMPLETION DATA:

(1) diameter (inches) 2

(2) total depth (feet) 65

(3) static water level (feet) 30' below top of ground.

(4) casing PVC, 60' (material) (depth)  
 (size) if telescope see back.

(5) screen 5' length, 60' depth to top  
 2" size, PVC material

(6) pump 1 (HP), 10 (yield gpm)  
 Elect (type power)

(7) electric log NO (yes or no)  
 (organization running log)


(8) how well bottom plugged  
 B.W.V.

DRILLERS REMARKS:

DEPT. OF NATURAL RESOURCES  
 BUREAU OF LAND & WATER RESOURCES  
 MAR - 9 1984  
 RECEIVED

If well telescopes please sketch and show depths.

GROUND LEVEL

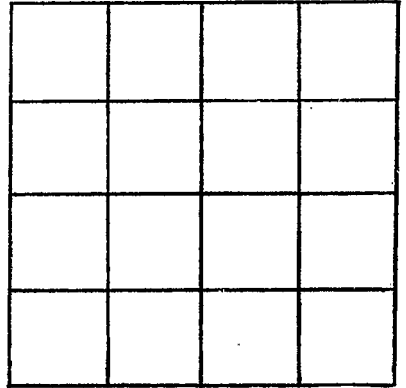

SECTION \_\_\_\_\_

Please indicate well location X.

ADDITIONAL INFORMATION

If more than one screen,  
show locations of each on sketch.