

MISSISSIPPI DEPARTMENT OF NATURAL RESOURCES

Bureau of Land and Water Resources

Southport Mall

P.O. Box 10631

Jackson, Mississippi 39209

WATER WELL DRILLERS LOG

Stone
G-2087
5-10-85

5-10

date well completed

19

Frank Price

firm name

Stone

county well located

LANDOWNER:

Charles Denning

(mailing address)

WELL LOCATION:

sec. 12 T. 3 S. R. 11 E.
1/2 miles S of Big Level
(distance) (direction) (nearest town)

WELL PURPOSE: HOME
(home, irrigation, municipal, industrial)

WELL COMPLETION DATA:

- (1) diameter (inches) 2"
- (2) total depth (feet) 83'
- (3) static water level (feet) 20' below top of ground.
- (4) casing PVC, 78' (material) (depth)
- (size) if telescope see back.
- (5) screen 5' 78' (length) (depth to top)
- 2" PVC (size) (material)
- (6) pump 1 (HP) 9 (yield gpm)
- Elect (type power)
- (7) electric log no (yes or no)

(organization running log)

(8) how well bottom plugged

BWV

DRILLERS REMARKS:

description of formations encountered

from

to

Top Soil

0 2

Sandy clay


2 18

Fine Sand

18 70

Coarse Sand


70 83

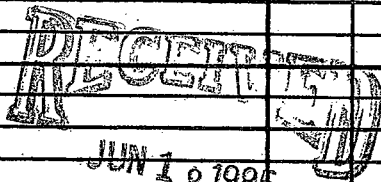

Department of Natural Resources
Bureau of Land & Water Resources

If well telescopes please sketch and show depths.

GROUND LEVEL

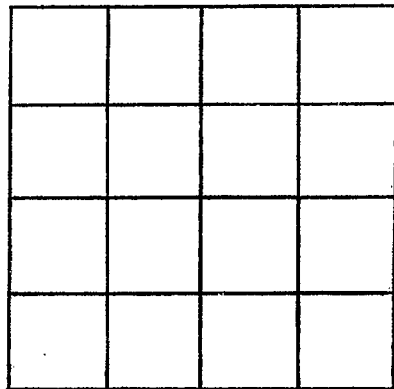

SECTION _____

Please indicate well location X.

ADDITIONAL INFORMATION

If more than one screen,
show locations of each on sketch.