

MISSISSIPPI DEPARTMENT OF NATURAL RESOURCES

Bureau of Land and Water Resources

Southport Mall

P.O. Box 10631

Jackson, Mississippi 39209

WATER WELL DRILLERS LOG

Stone
G-2088
5-20-85

5-20
date well completed

19 85- Frank Price
firm name

Stone
county well located

LANDOWNER:
Carl Breland
(mailing address)

description of formations encountered	from	to
Top Soil	0	2
Course Sand	2	38
Clay	38	275
Course Sand	275	290

WELL LOCATION:
sec. 30 T. 3 S. R. 11 W. of Perk
1 miles 5 (distance) (direction) (nearest town)

WELL PURPOSE: HOME
(home, irrigation, municipal, industrial)

WELL COMPLETION DATA:

(1) diameter (inches) 4"

(2) total depth (feet) 290'

(3) static water level (feet) 170' below top of ground.

(4) casing PVC, 280' (material) (depth)


(size) If telescope see back.

(5) screen 10', 280' (length) (depth to top)
4" PVC (size) (material)

(6) pump 1 (HP) 10 (yield gpm)
Elect (type power)

(7) electric log no (yes or no)
(organization running log)

(8) how well bottom plugged BWV

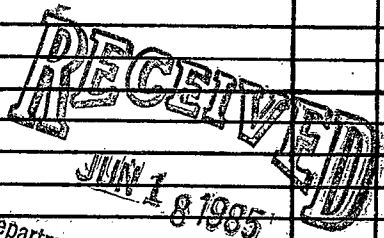


Department of Natural Resources
Bureau of Land & Water Resources

DRILLERS REMARKS:

If well telescopes please sketch and show depths.

GROUND LEVEL

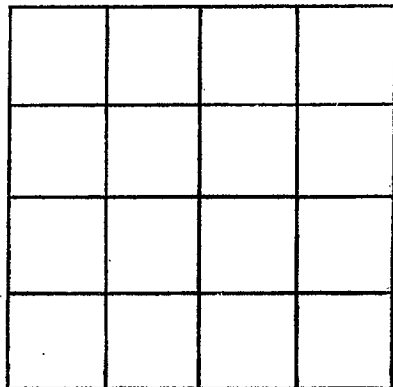

SECTION _____

Please indicate well location X.

ADDITIONAL INFORMATION

If more than one screen,
show locations of each on sketch.