

MISSISSIPPI DEPARTMENT OF NATURAL RESOURCES

Bureau of Land and Water Resources

Southport Mall

P.O. Box 10631

Jackson, Mississippi 39209

WATER WELL DRILLERS LOG

STONE
G 208

7-24 1985
date well completed

Frank Price
firm name

Stone
county well located

LANDOWNER:

Buddy Eley
(mailing address)

description of formations encountered

from to

Top Soil	0	2
Sandy Clay	2	18
Coarse Sand	18	65

WELL LOCATION:

sec 30 T. 3 S R. 11 E
1 1/2 miles S of PI-RK
(distance) (direction) (nearest town)

WELL PURPOSE: HOME
(home, irrigation, municipal, industrial)

WELL COMPLETION DATA:

- (1) diameter (inches) 2"
- (2) total depth (feet) 65'
- (3) static water level (feet) 45' below top of ground
- (4) casing PVC 60' (material) (depth)
- (5) screen 5' 60' (length) (depth to top)
- (6) pump 1/2 (HP) 8 (yield gpm)
Elect (type power)
- (7) electric log no (yes or no)

(organization running log)

(8) how well bottom plugged
B/W

DRILLERS REMARKS:


RECEIVED

NOV 19 1985

Department of Natural Resources
Bureau of Land & Water Resources

If well telescopes please
sketch and show depths.

GROUND LEVEL

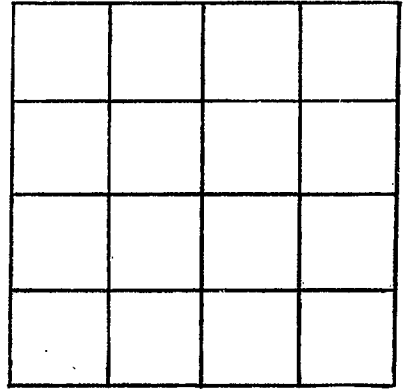

SECTION _____

Please indicate well location X.

ADDITIONAL INFORMATION

If more than one screen,
show locations of each on sketch.