

MISSISSIPPI DEPARTMENT OF NATURAL RESOURCES

Bureau of Land and Water Resources

Southport Mall

P.O. Box 10631

Jackson, Mississippi 39209

WATER WELL DRILLERS LOG

STONE
G 2090

8-2 1985 FRANK PRICE STONE
date well completed firm name county well located

LANDOWNER:	description of formations encountered	from	to
VAN ROLAND			
(mailing address)	RED SAND CLAY	2	40
WELL LOCATION:	FINE SAND	40	50
sec. 32 T. 3 R. 11	COURSE SAND	50	65
2 miles E HWY 49			
(distance) (direction) (nearest town)			

WELL PURPOSE: HOME
(home, irrigation, municipal, industrial)

WELL COMPLETION DATA:

(1) diameter (inches) 2"

(2) total depth (feet) 65'

(3) static water level (feet) 35' below top of ground.

(4) casing PCV, 60' (material) (depth)
(size) if telescope see back.

(5) screen 5' (length), 60' (depth to top)
2" (size), PCV (material)

(6) pump 1 (HP), 7 (yield gpm)
ELECT (type power)

(7) electric log NO (yes or no)
NO (organization running log)

(8) how well bottom plugged B w v

RECEIVED


NOV 20 1985

Department of Natural Resources
Bureau of Land & Water Resources

DRILLERS REMARKS:

If well telescopes please sketch and show depths.

GROUND LEVEL

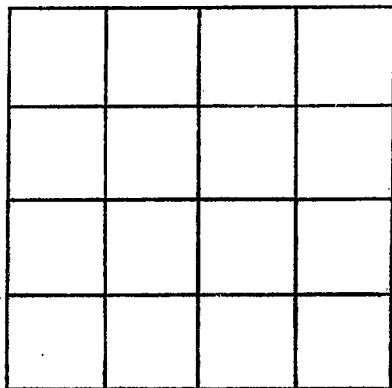

SECTION _____

Please indicate well location X.

ADDITIONAL INFORMATION

If more than one screen,
show locations of each on sketch.