

MISSISSIPPI DEPARTMENT OF NATURAL RESOURCES

Bureau of Land and Water Resources

Southport Mall

P.O. Box 10631

Jackson, Mississippi 39209

WATER WELL DRILLERS LOG

STONE
G 2091

914 19 83 FRANK PRICE STONE
 date well completed firm name county well located

LANDOWNER:	description of formations encountered	from	to
JAMES JEFFON			
(mailing address)	RED SAND CLAY	2	40
WELL LOCATION: sec 30 T. 3 S. R. 11 E. W. 49	FINE SAND	40	50
1 miles E of HWY 49 (distance) (direction) (nearest town)	COURSE 11	50	83

WELL PURPOSE: HOME
 (home, irrigation, municipal, industrial)

WELL COMPLETION DATA:

(1) diameter (inches) 2"

(2) total depth (feet) 83'

(3) static water level (feet) 56' below top of ground.

(4) casing P.V.C. 78' (material) (depth)
 (size) if telescope see back.

(5) screen 5' 78' (length) (depth to top)
 2" P.V.C. (size) (material)

(6) pump 1 7 (HP) (yield gpm)
 ELECT (type power)

(7) electric log NO (yes or no)
 NO (organization running log)

(8) how well bottom plugged B W L

RECEIVED


NOV 19 1985

DRILLERS REMARKS:

Department of Natural Resources
 Bureau of Land & Water Resources
 Bureau of Land & Water Resources

If well telescopes please sketch and show depths.

GROUND LEVEL

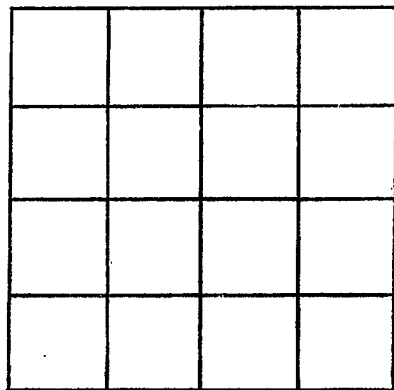

SECTION _____

Please indicate well location X.

ADDITIONAL INFORMATION

If more than one screen, show locations of each on sketch.