

MISSISSIPPI DEPARTMENT OF NATURAL RESOURCES

Bureau of Land and Water Resources

Southport Mall

P.O. Box 10631

Jackson, Mississippi 39209

WATER WELL DRILLERS LOG

STONE
G-2052

9-16 1985 FRANK PRICE STONE
date well completed firm name county well located

LANDOWNER:	description of formations encountered	from	to
BILL MANTOX			
(mailing address)	RED SAND CLAY	2	30
WELL LOCATION:	FINE SAND	30	35
sec. 30 T 3 S R 11 W	COURSE SAND	35	45
1/2 miles E of HWY 49			
(distance) (direction) (nearest town)			

WELL PURPOSE: HOME
(home, irrigation, municipal, industrial)

- WELL COMPLETION DATA:
- (1) diameter (inches) 2"
 - (2) total depth (feet) 45'
 - (3) static water level (feet) 20" below top of ground.
 - (4) casing PVC, 40" (material) (depth)
(size) if telescope see back.
 - (5) screen 5" 40" (length) (depth to top)
2" PVC (size) (material)
 - (6) pump 1 9 (HP) (yield gpm)
ELECT (type power)
 - (7) electric log NO (yes or no)
NO (organization running log)
 - (8) how well bottom plugged B.W.V.


RECEIVED
NOV 20 1985

DRILLERS REMARKS:

Department of Natural Resources
Bureau of Land & Water Resources

If well telescopes please
sketch and show depths.

GROUND LEVEL

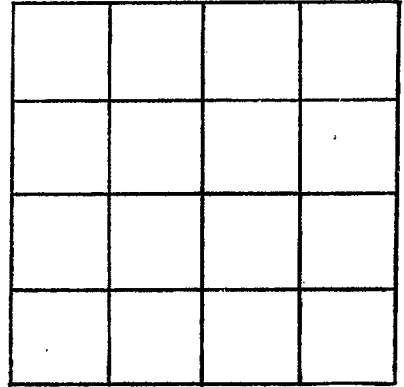

SECTION _____

Please indicate well location X.

ADDITIONAL INFORMATION

If more than one screen,
show locations of each on sketch.