

MISSISSIPPI DEPARTMENT OF NATURAL RESOURCES

Bureau of Land and Water Resources

Southport Mall

P.O. Box 10631

Jackson, Mississippi 39209

WATER WELL DRILLERS LOG

STONE
G2953

12-3

19

85 Frank Pisci

Stone

date well completed

firm name

county well located

LANDOWNER:

William Kendrick

(mailing address)

WELL LOCATION:

sec. 30 T. 3 S R. 11 W
2 miles S of Parkington
(distance) (direction) (nearest town)

WELL PURPOSE: HOME
(home, irrigation, municipal, industrial)

WELL COMPLETION DATA:

- (1) diameter (inches) 2"
- (2) total depth (feet) 57
- (3) static water level (feet) 20 below top of ground.
- (4) casing PVC, 46' (material) (depth)
- (size) if telescope see back.
- (5) screen 5' length, 46' depth to top
- 2" PVC (size) (material)
- (6) pump 1 HP, 8 yield gpm
- Elect (type power)
- (7) electric log no (yes or no)

(organization running log)

(8) how well bottom plugged Capped

DRILLERS REMARKS:

description of formations encountered

from

to

Top Soil	0	2
clay	2	20
course sand	20	57


RECEIVED

JAN 6 1985

Department of Natural Resources
Bureau of Land & Water Resources

If well telescopes please
sketch and show depths.

GROUND LEVEL

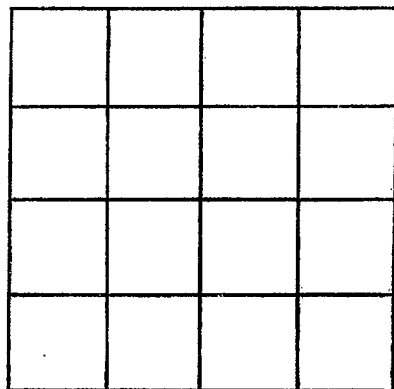

SECTION _____

Please indicate well location X.

ADDITIONAL INFORMATION

If more than one screen,
show locations of each on sketch.