

MISSISSIPPI DEPARTMENT OF NATURAL RESOURCES

Bureau of Land and Water Resources

Southport Mall

P.O. Box 10631

Jackson, Mississippi 39209

WATER WELL DRILLERS LOG

STONE
G 2074

12-20 1986
date well completed

Frank Rice
firm name

Stone
county well located

LANDOWNER:
Don Welch
(mailing address)

description of formations encountered	from	to
Top Soil	0	2
Clay	2	28
Thin Sand	28	85
Course Sand	85	100

WELL LOCATION:
sec. 18 T. 3 S. R. 12 E.
5 miles W of Arkhaston
(distance) (direction) (nearest town)

WELL PURPOSE: HOME
(home, irrigation, municipal, industrial)

WELL COMPLETION DATA:

(1) diameter (inches) 2"

(2) total depth (feet) 100'

(3) static water level (feet) 50' below top of ground.

(4) casing PVC 95' (material) (depth)
(size) if telescope see back.

(5) screen 5' 95' (length) (depth to top)
2" PVC (size) (material)

(6) pump 1 (HP) 8 (yield gpm)
Elect (type power)

(7) electric log No (yes or no)
(organization running log)

(8) how well bottom plugged BWV

RECEIVED


OCT 15 1987

Department of Natural Resources
Bureau of Land & Water Resources

DRILLERS REMARKS:

If well telescopes please sketch and show depths.

GROUND LEVEL

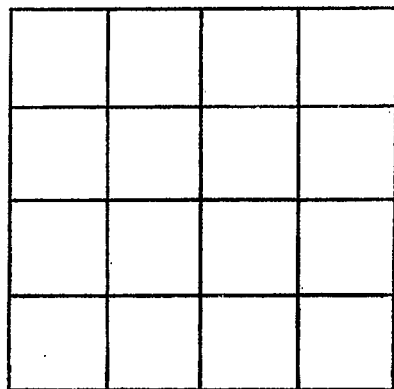

SECTION _____

Please indicate well location X.

ADDITIONAL INFORMATION

If more than one screen,
show locations of each on sketch.