

MISSISSIPPI DEPARTMENT OF NATURAL RESOURCES

Bureau of Land and Water Resources

Southport Mall

P.O. Box 10631

Jackson, Mississippi 39209

WATER WELL DRILLERS LOG

STONE  
CT 2096

3-24

date well completed

19

86 Parnell Anderson

firm name

STONE county well located

LANDOWNER: C.W. Fore  
Rt 3 PERKINSTON

MIS  
(mailing address)

description of formations encountered

from to

Top Soil	0	2
Clay	2	12
Sand	12	32
Clay	32	38
Sand	38	54


WELL LOCATION:

sec. 30 T. 3 N. R. 11 E. S. 3 W.  
3 miles S-E of Perkinston  
(distance) (direction) (nearest town)

WELL PURPOSE: Home  
(home, irrigation, municipal, industrial)

WELL COMPLETION DATA:

- (1) diameter (inches) 2
- (2) total depth (feet) 54
- (3) static water level (feet) 36 below above top of ground.
- (4) casing PVC, 49,  
(material) (depth)  
         if telescope see back.  
(size)
- (5) screen 5, 49  
(length) (depth to top)  
2, PVC  
(size) (material)
- (6) pump 1, 7  
(HP) (yield gpm)  
Elec  
(type power)
- (7) electric log NO  
(yes or no)  
          
(organization running log)
- (8) how well bottom plugged Cap

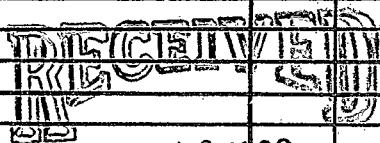


JUN 12 1986

Department of Natural Resources  
Bureau of Land & Water Resources

DRILLERS REMARKS:

If well telescopes please sketch and show depths.

GROUND LEVEL

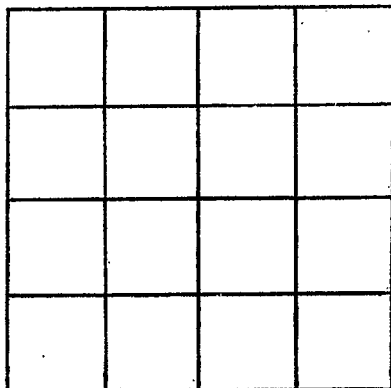

SECTION \_\_\_\_\_

Please indicate well location X.

ADDITIONAL INFORMATION

If more than one screen,  
show locations of each on sketch.