

MISSISSIPPI DEPARTMENT OF NATURAL RESOURCES

Bureau of Land and Water Resources

Southport Mall

P.O. Box 10631

Jackson, Mississippi 39209

WATER WELL DRILLERS LOG

STONE
G 2078

4-1

19

810

FRANK PRICE

Stone

date well completed

firm name

county well located

LANDOWNER:

John Price

(mailing address)

WELL LOCATION:

sec. 36 T-3 R-11 S-5  
 11 miles E of Perk  
 (distance) (direction) (nearest town)

WELL PURPOSE: HOME  
 (home, irrigation, municipal, industrial)

WELL COMPLETION DATA:

- (1) diameter (inches) 2"
- (2) total depth (feet) 98'
- (3) static water level (feet) 50' below above top of ground.
- (4) casing PVC, 78' (material) (depth)
- (size) If telescope see back.
- (5) screen 2" 5' 78' (length) (depth to top)  
 2" PVC (size) (material)
- (6) pump 1 (HP) 10 (yield gpm)  
 Elect. (type power)
- (7) electric log no (yes or no)

(organization running log)


(8) how well bottom plugged B.W.V

description of formations encountered

from

to

Top Soil	0	7
Sandy Clay	2	18
Clay	18	84
Coarse Sand	84	98

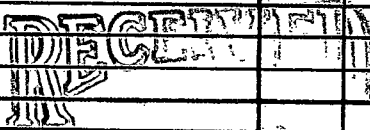


AUG 1 1986

Department of Natural Resources  
 Bureau of Land and Water Resources

DRILLERS REMARKS:

If well telescopes please sketch and show depths.

GROUND LEVEL

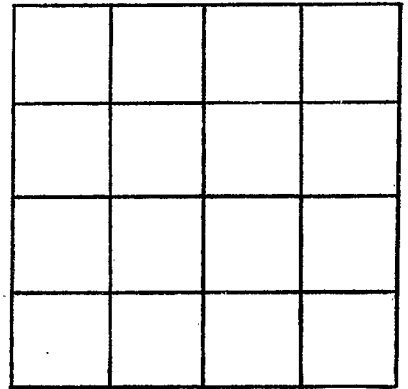

SECTION \_\_\_\_\_

Please indicate well location X.

ADDITIONAL INFORMATION

If more than one screen, show locations of each on sketch.