



If well telescopes please sketch and show depths.

GROUND LEVEL


4" Sch 40 PVC

4" x 2" PVC  
Bushing

2.70 FT  
2" x 10 FT PVC  
Screen

2" PVC Sand  
Shank

12.50 FT

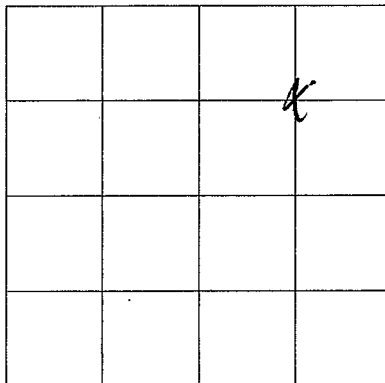

SECTION

35

Please indicate well location X.

ADDITIONAL INFORMATION

If more than one screen,  
show location of each on sketch.