

MISSISSIPPI DEPARTMENT OF NATURAL RESOURCES

Bureau of Land and Water Resources

Southport Mall

P.O. Box 10631

Jackson, Mississippi 39209

WATER WELL DRILLERS LOG

STONE  
G 2009

3-16 1987 Frank Price Stone  
date well completed firm name county well located

LANDOWNER:  
Jim Smith  
(mailing address)

WELL LOCATION:  
sec. 5 T 3 N R 11 E  
2 miles S.E. of Wiggins  
(distance) (direction) (nearest town)

WELL PURPOSE: HOME  
(home, irrigation, municipal, industrial)

WELL COMPLETION DATA:

(1) diameter (inches) 2"  
(2) total depth (feet) 63'  
(3) static water level (feet) 40' below top of ground.  
(4) casing PVC, 8-8' (material) (depth)  
(size) if telescope see back:  
(5) screen 5' length, 5-8' depth to top  
2" PVC (size) (material)  
(6) pump 1 HP, 9 (type power) (yield gpm)  
Elect  
(7) electric log no (yes or no)  
(organization running log)  
(8) how well bottom plugged B.W.V.

description of formations encountered	from	to
Top Soil	0	2
Red Clay	2	12
Fine Sand	12	38
Coarse Sand	38	63

RECEIVED


OCT 15 1987

Department of Natural Resources  
Bureau of Land & Water Resources

DRILLERS REMARKS:

If well telescopes please sketch and show depths.

GROUND LEVEL

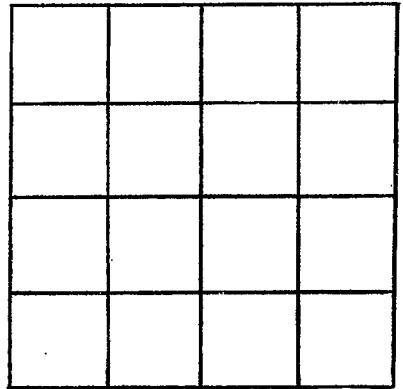

SECTION \_\_\_\_\_

Please indicate well location X.

ADDITIONAL INFORMATION

If more than one screen,  
show locations of each on sketch.