

MISSISSIPPI DEPARTMENT OF NATURAL RESOURCES

Bureau of Land and Water Resources

Southport Mall

P.O. Box 10631

Jackson, Mississippi 39209

WATER WELL DRILLERS LOG

STONE
G-2100

2-9
date well completed

1987 Frank Price
firm name

Stone
county well located

LANDOWNER:
Doug Sullivan

(mailing address)

description of formations encountered	from	to
<u>Top Soil</u>	<u>0</u>	<u>2</u>
<u>Course Sand</u>	<u>2</u>	<u>35</u>

WELL LOCATION:
 sec 30 T 3 R 11
1 1/2 miles S of Perkins
 (distance) (direction) (nearest town)

WELL PURPOSE: HOME
 (home, irrigation, municipal, industrial)

WELL COMPLETION DATA:

(1) diameter (inches) 2"

(2) total depth (feet) 35'

(3) static water level (feet) 25' below top of ground.

(4) casing PVC, 30'
 (material) (depth)
 (size) if telescope see back.

(5) screen 5', 30'
 (length) (depth to top)
2", PVC
 (size) (material)

(6) pump 1, 9
 (HP) (yield gpm)
Elect
 (type power)

(7) electric log no
 (yes or no)
 (organization running log)

(8) how well bottom plugged
BWW

RECEIVED


OCT 15 1987

Department of Natural Resources
Bureau of Land & Water Resources

DRILLERS REMARKS:

If well telescopes please
sketch and show depths.

GROUND LEVEL

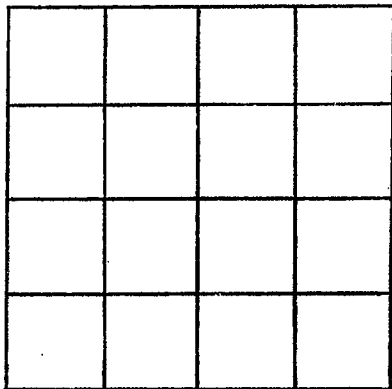

SECTION _____

Please indicate well location X.

ADDITIONAL INFORMATION

If more than one screen,
show locations of each on sketch.