

# MISSISSIPPI DEPARTMENT OF NATURAL RESOURCES

Bureau of Land and Water Resources

P.O. Box 10631  
Jackson, Mississippi 39209  
WATER WELL DRILLERS LOG

WELL LOCATED  
*Stone*

WELL NUMBER  
*G2102*

DATE WELL COMPLETED  
*10-19-87*

PERMIT NUMBER

NAME OF DRILLING FIRM  
*Mark Drilling Co.*

NAME & MAILING ADDRESS OF LANDOWNER  
*Bondy Eaton*

*Rt. 3 Box 56 F - Highway 99*

*Perkins, Miss. 39572*

WELL LOCATION: SEC *31* TOWNSHIP *3 S* RANGE *11 W*

DISTANCE *2 1/2* MILES *N* DIRECTION of NEAREST TOWN *McHenry*

OTHER LANDMARK

WELL PURPOSE: Home Irrigation, Municipal, Industrial, Fish Pond, etc.  
*Home*

**PUMP DATA**

PUMP TYPE (Circle One):  
Submersible, Turbine, Jet Flowing Well,  
Other (Describe) \_\_\_\_\_

POWER TYPE (Circle One):  
Electric Tractor, Diesel, Gasoline, Butane,  
Other (Describe) \_\_\_\_\_

Pump Capacity (GPM) *6* No. of Stages *2* Setting Depth *80* FT.

PUMP TEST

Well yielded \_\_\_\_\_ GPM with  
a drawdown of \_\_\_\_\_ ft.  
after \_\_\_\_\_ hours of pumping

**WELL DATA**

Well Depth *140* Casing Diameter (In.) *2 1/2* Casing Length (Ft.) *130*

Type of Casing *PVC* Hole Depth *140* Depth to Static Water Level *62*

TYPE OF COMPLETION: (Circle One or More):  
Natural Development Gravel Packed, Underreamed, Telescoped,  
Open Hole, Other

Top of Lap Pipe or Reduction in Casing  
FEET IF TELESCOPED OR MORE THAN ONE SCREEN: USE BACK PAGE

**LOG DATA**

TYPE OF LOG RUN (Circle One):  
Electric, Gamma Ray, Density, Sonic, No Log Run, Neutron,  
Other (Describe) \_\_\_\_\_

Name of Organization Running Log

**SCREEN DATA**

Diameter - Inches *2* Length - Feet *10* Slot Size - Inches *.008*

Screen Type *PVC WSP* Depth to Bottom - Feet *140*

**GEOLOGIC DATA (Office Use Only)**

Surface Elev.	Geologic Unit	Unit Thickness	Depth to Top
Subs. SWL	Date	Analysis	Aquifer Test

Driller's Remarks


DESCRIPTION OF FORMATIONS ENCOUNTERED	FROM	TO	FORMATIONS (continued)	FROM	TO
<i>Surface</i>	<i>0</i>	<i>4</i>			
<i>Red Clay</i>	<i>4</i>	<i>24</i>			
<i>White Clay</i>	<i>24</i>	<i>91</i>			
<i>White Sand</i>	<i>91</i>	<i>140</i>			

**RECEIVED**  
**FEB 22 1988**  
Department of Natural Resources  
Bureau of Land & Water Resources

IF MORE SPACE IS NEEDED, USE BACK

If well telescopes please sketch and show depths.

GROUND LEVEL

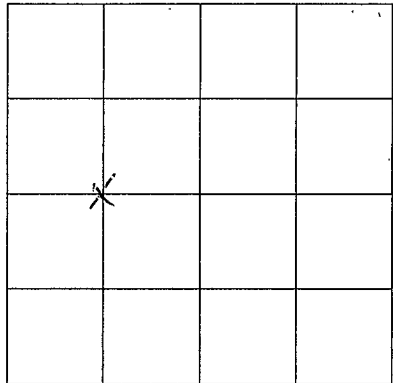

SECTION 31

Please indicate well location X.

ADDITIONAL INFORMATION

If more than one screen,  
show location of each on sketch.