

MS DEPARTMENT OF ENVIRONMENTAL QUALITY

Office of Land and Water Resources

P. O. Box 10631
Jackson, MS 39289-0631
WATER WELL DRILLERS LOG

COUNTY Wade
State
WELL NUMBER G USED
DATE WELL COMPLETED 2/05
9/18/93

PERMIT NUMBER
NAME OF DRILLING FIRM
Moore's Water Well Serv
Wiggins, MS

NAME & MAILING ADDRESS OF LANDOWNER
Lisa Pettis
36 Jordan Rd.
WELL LOCATION: SEC 34 TOWNSHIP 3 RANGE 11 W
DISTANCE 8 Miles DIRECTION SE of NEAREST TOWN Wiggins
OTHER LANDMARK 3 miles Big level NW of Sunflower
WELL PURPOSE: Home, Irrigation, Municipal, Industrial, Fish Pond, etc.
Home

PUMP DATA
PUMP TYPE (Circle One):
Submersible, Turbine, Jet Flowing Well,
Other (Describe)
POWER TYPE (Circle One):
Electric, Tractor, Diesel, Gasoline, Butane,
Other (Describe) H/P
Pump Capacity (GPM) 10 No. of Stages 2 Setting Depth FT.
PUMP TEST
Well yielded GPM with
a drawdown of ft.
after hours of pumping

WELL DATA
Well Depth 53' Casing Diameter (In.) 2" Casing Length (Ft.) 43'
Type of Casing PVC Hole Depth 53' Depth to Static Water Level 40'
TYPE OF COMPLETION: (Circle One or More):
Gravel Packed, Underreamed, Telescoped,
Natural Development, Open Hole, Other
WELL GROUTED TO A DEPTH OF 10 FEET
Type Grout (circle one) Cement, Bentonite, or Mix

LOG DATA
TYPE OF LOG RUN (Circle One): No Log Run,
Electric, Gamma Ray, Density, Sonic, Neutron,
Other (Describe)
Name of Organization Running Log

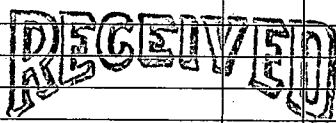
SCREEN DATA
Diameter - Inches 2" Length - Feet 10' Slot Size - Inches .010
Screen Type PVC Shc. 40 Depth to Bottom - Feet 53'

GEOLOGIC DATA (Office Use Only)

Surface Elev.	Geologic Unit	Unit Thickness	Depth to Top
Subs. SWL	Date	Analysis	Aquifer Test

Driller's Remarks

DESCRIPTION OF FORMATIONS ENCOUNTERED	FROM	TO
Top Soil	0'	5'
red clay	5'	17'
white sand	17'	39'
white soapstone	39'	40'
Coarse white sand peagravel	40'	53'

FORMATIONS (Continued)	FROM	TO
 SEP 21 1993 Dept. of Environmental Quality Office of Land & Water Resources		
IF MORE SPACE IS NEEDED, USE BACK		

If well telescopes please
sketch and show depths.

GROUND LEVEL

SECTION _____

Please indicate well location X.

ADDITIONAL INFORMATION

If more than one screen,
show location of each on sketch.