

STONE MISSISSIPPI BOARD OF WATER COMMISSIONERS

WATER WELL DRILLERS LOG

C. I. SWITZER WELL CO.

Date: 4-14, 1964, Driller: _____ County Stone

(Name)

(1) Owner of Land: Handy King
 (Name)
St. 1, Parkington
 (Address)

(2) Location: 1/4, SE 1/4, Sec. 21, T. 359N, R. 1W
 _____ miles _____ of _____
 (distance) (direction) (Nearest Town)

(3) Topography: _____
 (Hilly) (Flat) (Level)

(4) Purpose of Well: Domestic
 (Domestic Irrigation
 Municipal, Industrial, Other)

Information upon completion of well:

(1) Diameter 2" inches.

(2) Total Depth 350 feet.

(3) Water Level 5 1/2' + feet below top of ground.

(4) Cased to 350', Size 2"

(5) Screen: Size 2", Length 10'

(6) Were any formations sealed against pollution?
 yes, _____ no.


If YES depth of formation _____

Why North Dept. requirement

Drillers Remarks: _____

Description & Color of Materials Sand, Clay, Red Clay, Shell, etc.	Thick- ness Feet	Depth Feet
clay	80	10
sand	10	24
clay	24	100
sand, fine	100	118
clay	110	138
sand	138	140
sand w/ 2 shells	110	160
sand	160	170
clay	170	200
sand	200	210
clay	210	230
sand	230	240
sand, real fine	240	260
sand w/ clay shks	260	280
clay	280	310
sand	310	320
sand, real good	320	350

Location from driller
3 1/2 mi SW

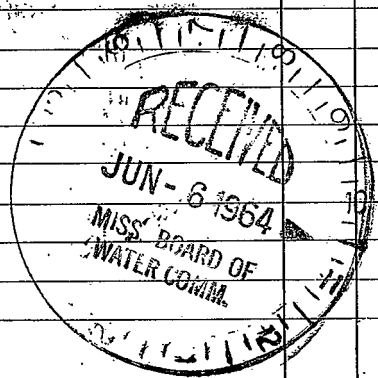

(Use Back Side)

Well No.

1870

The first of the year was a very
 cold one, and the snow lay
 deep on the ground. The
 weather was very disagreeable
 and the people were
 much distressed. The
 crops were all killed
 and the stock was
 starved. The
 people were
 very poor and
 the country was
 very desolate.

1871

The second of the year was a
 very warm one, and the
 snow melted. The
 weather was very pleasant
 and the people were
 much relieved. The
 crops were all saved
 and the stock was
 well fed. The
 people were
 very happy and
 the country was
 very fertile.