

30445N 0885340

**CODED**  
**CODED**  
 5/27/70  
 rec'd bank 5/28/70  
 J.E.S.

Stone  
 H4  
 6-68

MISSISSIPPI  
 BOARD OF WATER COMMISSIONERS  
 416 North State Street  
 Jackson, Mississippi 39201

WATER WELL DRILLERS LOG

6-12 1968 Switzer Well Co. Stone  
 date well completed firm name county well located

LANDOWNER: Mrs. Chester Balice

902 N. Bayview Ave.

Biloxi Miss  
 (mailing address)

WELL LOCATION:

sec 33 T 3 S R 9 W  
28 miles N of Biloxi  
 (distance) (direction) (nearest town)

WELL PURPOSE: home  
 (home, irrigation, municipal, industrial)

WELL COMPLETION DATA:

(1) diameter (inches) 2

(2) total depth (feet) 570

(3) static water level (feet) 105'4" below top of ground.

(4) casing gal steel 95'4"  
 (material) (depth)

2" if telescope see back.  
 (size)

(5) screen 10' 560  
 (length) (depth to top)

8 ga. SS on pipe  
 (size) (material)

(6) pump 1 6  
 (HP) (yield gpm)

electric  
 (type power)

(7) electric log No  
 (yes or no)

(organization running log)

(8) how well bottom plugged Back pressure valve

DRILLERS REMARKS: Well drilled deeper. Old well 56 ft. deep

description of formations encountered	from	to
old well	0	42
clay	42	99
fine sand	99	147
fair sand	147	168
clay	168	189
good sand	189	220
clay	220	247
mixed	247	330
fine sand	330	373
sand	373	375
fine clay	375	394
clay	394	425
fine sand	425	437
mixed	437	451
clay	451	465
sand	465	472
fine sand	472	509
good sand	509	570


~~Was the well actually made at this depth? J.E.S.~~

J.E.S. 5-15-70

**CODED**  
 MISS. Bd. OF WATER COMMISSIONERS

If well telescopes please sketch and show depths.

GROUND LEVEL

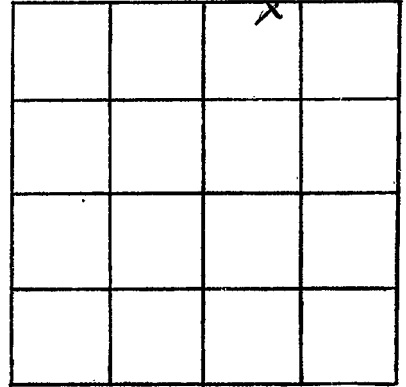

SECTION 3.3

Please indicate well location X.

ADDITIONAL INFORMATION

If more than one screen, show locations of each on sketch.