

STONE  
H 5  
8-68

MISSISSIPPI  
BOARD OF WATER COMMISSIONERS  
416 North State Street  
Jackson, Mississippi 39201

CODED

WATER WELL DRILLERS LOG

8-1 1968 Farnell Anderson STONE  
date well completed firm name county well located

LANDOWNER: Wilton L. Bowd

description of formations encountered	from	to
Topsoil + sand	0	12
Red Clay	12	30
Fine Sand	30	33
Pink Clay	33	40
Fine Sand	40	60
Pink Clay	60	70
Coarse Sand	70	80

Perkinston Miss  
(mailing address)


WELL LOCATION:  
sec 36 T 3 S R 10 W  
15 miles E of Perkinston  
(distance) (direction) (nearest town)

WELL PURPOSE: Home  
(home, irrigation, municipal, industrial)

WELL COMPLETION DATA:


- (1) diameter (inches) 2"
- (2) total depth (feet) 80
- (3) static water level (feet) 65 below top of ground.
- (4) casing Plastic, 74 (material), (depth)  
2" (size) if telescope see back.
- (5) screen 6, 74 (length), (depth to top)  
2" Plastic (size), (material)
- (6) pump 1, 7 (HP), (yield gpm)  
Electricity (type power)
- (7) electric log NO (yes or no)  
(organization running log)
- (8) how well bottom plugged Back- Wash Valve

DRILLERS REMARKS:

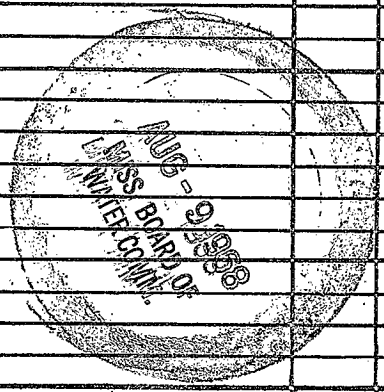

If well telescopes please sketch and show depths.

GROUND LEVEL

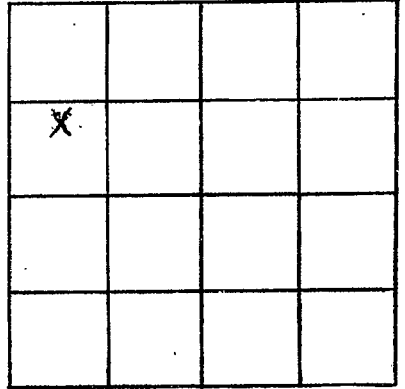

SECTION 36

Please indicate well location X.

ADDITIONAL INFORMATION

If more than one screen, show locations of each on sketch.