

Stone
H 6
8-3-68

MISSISSIPPI
BOARD OF WATER COMMISSIONERS
416 North State Street
Jackson, Mississippi 39201

CODED

WATER WELL DRILLERS LOG

8-9 1968 L W Smith Stone
date well completed firm name county well located

LANDOWNER:

B J alexander
Wiggins Rd.
(mailing address)

description of formations encountered

Top S.
Clay
Sand
Clay

from	to
0	2
2	18
18	30
30	38

WELL LOCATION:

sec 31 T 3 S R 9 W
15 miles S.E. of Wiggins
(distance) (direction) (nearest town)

WELL PURPOSE:

(home, irrigation, municipal, industrial)

CODED

WELL COMPLETION DATA:

- (1) diameter (inches) 2
- (2) total depth (feet) 30
- (3) static water level (feet) 27 below top of ground.
- (4) casing Plastic 30 (material) (depth)
if telescope see back. (size)
- (5) screen 5 25 (length) (depth to top)
(size) (material)
- (6) pump 1 12 (HP) (yield gpm)
Electric (type power)
- (7) electric log (yes or no)
(organization running log)
- (8) how well bottom plugged Bachu


FEB - 1 1968

MISS. BD. OF
WATER COMM

DRILLERS REMARKS:

If well telescopes please sketch and show depths.

GROUND LEVEL

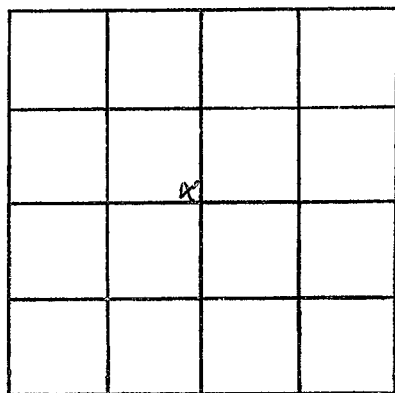

SECTION 31

Please indicate well location X.

ADDITIONAL INFORMATION

If more than one screen,
show locations of each on sketch.