

STONE
H 10
7-16-70

MISSISSIPPI
BOARD OF WATER COMMISSIONERS
416 North State Street
Jackson, Mississippi 39201

CODED

WATER WELL DRILLERS LOG

7/16/70 date well completed 1970 M. H. Shell Co firm name Stone county well located

LANDOWNER: Sant Bond
Wiggins Miss
(mailing address)

description of formations encountered	from	to
Dirt	0	2
Red Clay	2	8
White Clay	8	20
Sand	20	54
White Clay	54	58
Sand	58	68
Blue Clay	68	189
Silt Sand	189	193
Blue Clay +		
White Speck Clay	193	219
Sand	219	231

WELL LOCATION:
sec 32 T 3 N R 9 E
3 miles S.W. of Rosney
(distance) (direction) (nearest town)

WELL PURPOSE: Home
(home, irrigation, municipal, industrial)

WELL COMPLETION DATA:

(1) diameter (inches) 4"

(2) total depth (feet) 231

(3) static water level (feet) 78 (below above top of ground)

(4) casing Plastic, 221 (material) (depth)

(size) if telescope see back.

(5) screen 10ft, 221 (length) (depth to top)
4" Plastic (size) (material)

(6) pump 2 (HP) 60 (yield/gpm)
Electric (type power)

(7) electric log No (yes or no)

(organization running log)

(8) how well bottom plugged Back
Wash Valve

CODED


MISS. - 3 1970

DRILLERS REMARKS:

MISS. BD. OF
WATER COMMISSIONERS

If well telescopes please sketch and show depths.

GROUND LEVEL

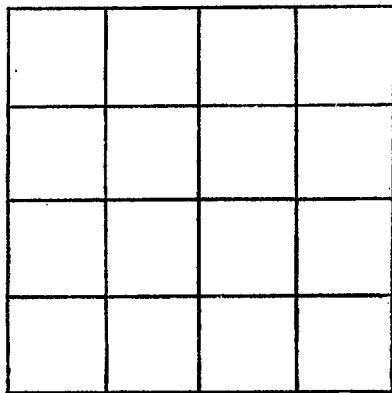

SECTION _____

Please indicate well location X.

ADDITIONAL INFORMATION

If more than one screen, show locations of each on sketch.