

STONE
H 11
5-5-71

MISSISSIPPI
BOARD OF WATER COMMISSIONERS
416 North State Street
Jackson, Mississippi 39201

CODED

WATER WELL DRILLERS LOG

5-5-71
date well completed

1971 Parnell Anderson
firm name

Stone
county well located

LANDOWNER: Joe Amalga
Rt. 4
Perkinston Miss
(mailing address)

description of formations encountered	from	to
Top Soil	6	8
Red Clay	8	9
Fine Sand	9	35
Coarse Sand	35	49

WELL LOCATION:
sec. 9 T. 3 S. R. 10 W.
12 miles East of Wiggins
(distance) (direction) (nearest town)

WELL PURPOSE: ~~Home~~
(home, irrigation, municipal, industrial)

- WELL COMPLETION DATA:
- (1) diameter (inches) 2"
 - (2) total depth (feet) 49'
 - (3) static water level (feet) 25' below top of ground
 - (4) casing Plastic, 43' (material) (depth)
(size) if telescope see back.
 - (5) screen 6' 43' (length) (depth to top)
2" Plastic (size) (material)
 - (6) pump 1 (HP) 10 (yield gpm)
Electric (type power)
 - (7) electric log no (yes or no)
- (organization running log)
- (8) how well bottom plugged Backwash Valve

CODED


NOV 9 1971

DRILLERS REMARKS:

MISS. BD. OF
WATER COM.

If well telescopes please sketch and show depths.

GROUND LEVEL

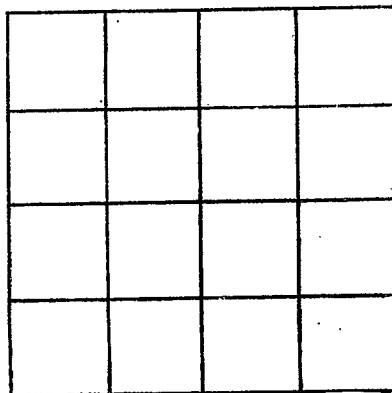

SECTION _____

Please indicate well location X.

ADDITIONAL INFORMATION

If more than one screen, show locations of each on sketch.