

MISSISSIPPI
BOARD OF WATER COMMISSIONERS
416 North State Street
Jackson, Mississippi 39201

CODED

WATER WELL DRILLERS LOG

STONE
H12
4-2-70

4-2 1970 Parwell Anderson Stone
date well completed firm name county well located

LANDOWNER: Delton Bond
Route 1 Perkinston
(mailing address)

WELL LOCATION:
sec. 26 T 3 S R. 10 W
16 miles E of Perkinston
(distance) (direction) (nearest town)

WELL PURPOSE: Home
(home, irrigation, municipal, industrial)

- WELL COMPLETION DATA:
- (1) diameter (inches) 2
 - (2) total depth (feet) 82
 - (3) static water level (feet) 50 below above top of ground.
 - (4) casing Plastic, 76,
(material) (depth)
(size) if telescope see back.
 - (5) screen 6, 76
(length) (depth to top)
2, Plast
(size) (material)
 - (6) pump 1, 9
(HP) (yield gpm)
Elect
(type power)
 - (7) electric log _____
(yes or no)
(organization running log) _____
 - (8) how well bottom plugged
Backwash Valve

description of formations encountered	from	to
Top soil	0	1
Sand	1	12
Red clay	12	31
Fine sand	31	52
Red clay	52	67
Fine sand	67	79
Coarse sand	79	82

CODED


JUN 11 1971

MISS. Bd. OF
WATER COM.

DRILLERS REMARKS:

If well telescopes please sketch and show depths.

GROUND LEVEL

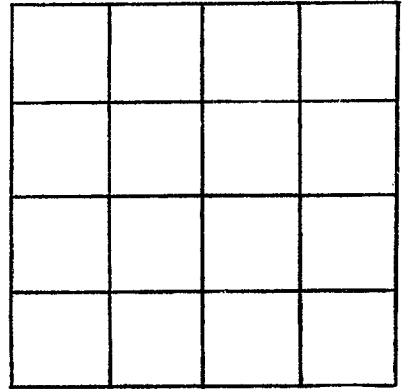

SECTION _____

Please indicate well location X.

ADDITIONAL INFORMATION

If more than one screen,
show locations of each on sketch.