

MISSISSIPPI
BOARD OF WATER COMMISSIONERS
416 North State Street
Jackson, Mississippi 39201

CODED

WATER WELL DRILLERS LOG

STONE
H 13
8-16-70

8-16 1970 Barnell Anderson STONE
date well completed firm name county well located

LANDOWNER: Esco, W. Bond
Route 1 Parkinston
(mailing address)

WELL LOCATION:
sec. 9 T. 3 N. R. 10 E
S W
13 miles E of Wiggins
(distance) (direction) (nearest town)

WELL PURPOSE: Home
(home, irrigation, municipal, industrial)

- WELL COMPLETION DATA:
- (1) diameter (inches) 2
 - (2) total depth (feet) 76
 - (3) static water level (feet) 43 below above top of ground.
 - (4) casing Plastic, 70
(material) (depth)
 if telescope see back.
(size)
 - (5) screen 6' 70
(length) (depth to top)
2' Plastic
(size) (material)
 - (6) pump 1 7
(HP) (yield gpm)
ElecT
(type power)
 - (7) electric log
(yes or no)

(organization running log)
 - (8) how well bottom plugged Backwash Valve

description of formations encountered	from	to
Top Soil	0	3
Red Clay	3	24
Fine Sand	24	31
Red Clay	31	48
Fine Sand	48	53
Pink Clay	53	60
Fine Sand	60	66
Coarse Sand	66	76

CODED


JUN 11 1971

DRILLERS REMARKS:

MISS. BD. OF
WATER COMM.

If well telescopes please sketch and show depths.

GROUND LEVEL

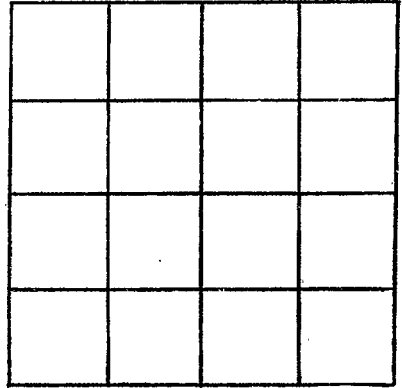

SECTION _____

Please indicate well location X.

ADDITIONAL INFORMATION

If more than one screen, show locations of each on sketch.