

STONE  
H-14  
6-25-71

MISSISSIPPI  
BOARD OF WATER COMMISSIONERS  
416 North State Street  
Jackson, Mississippi 39201

**CODED**

WATER WELL DRILLERS LOG

6-25 1971 Parwell Anderson Stone  
date well completed firm name county well located

LANDOWNER: H.H. Heard  
Route 1 Perkinston  
(mailing address)

description of formations encountered	from	to
TOP Soil	0	3
Red Sand	3	23
White Clay	23	71
Fine Sand	71	88
Coarse Sand & Gravel	88	104

WELL LOCATION:  
sec. 6 T. 3 S. R. 10 E  
10 miles E of Wiggins  
(distance) (direction) (nearest town)

WELL PURPOSE: Farm  
(home, irrigation, municipal, industrial)


- WELL COMPLETION DATA:
- (1) diameter (inches) 2
  - (2) total depth (feet) 104
  - (3) static water level (feet) 50 below above top of ground.
  - (4) casing Plastic 98 (material) (depth)
  - (size) if telescope see back.
  - (5) screen 6' 98 (length) (depth to top)
  - 2" Plastic (size) (material)
  - (6) pump 1 11 (HP) (yield gpm)
  - Elect (type power)
  - (7) electric log (yes or no)
  - (organization running log)
  - (8) how well bottom plugged Backwash Valve

DRILLERS REMARKS:

AUG 30 1971  
MISS. BD. OF  
WATER COMM.

If well telescopes please sketch and show depths.

GROUND LEVEL

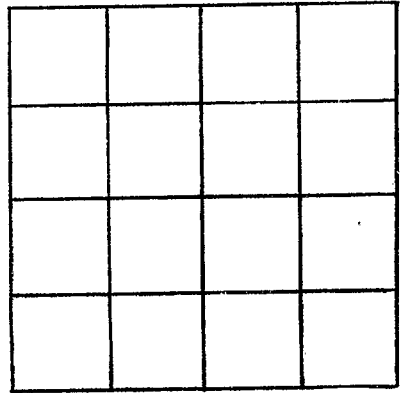

SECTION \_\_\_\_\_

Please indicate well location X.

ADDITIONAL INFORMATION

If more than one screen, show locations of each on sketch.