

STONE
H 15

MISSISSIPPI
BOARD OF WATER COMMISSIONERS
416 North State Street
Jackson, Mississippi 39201

CODED

10-1-71

WATER WELL DRILLERS LOG

10-1 1971
date well completed

Perwell Anderson
firm name

Stone
county well located

LANDOWNER: W.C. Flurry
RT 1 PERKINSTON

(mailing address)

description of formations
encountered

from to

Top Soil	0	3
Red Sand	3	24
Red Clay	24	29
Sand with clay st	29	78
Pink Clay	78	86
Five Sand	86	105
Coarse Sand	105	120

WELL LOCATION:

sec. 26 T. 3 S R. 10 E W
18 miles S of Perkinston
(distance) (direction) (nearest town)

WELL PURPOSE: HOME
(home, irrigation, municipal, industrial)

WELL COMPLETION DATA:

CODED

- (1) diameter (inches) 2
- (2) total depth (feet) 120
- (3) static water level (feet) 60 below above top of ground.
- (4) casing Pvc 115
(material) (depth)
- _____ if telescope see back.
(size)
- (5) screen 5, 115
(length) (depth to top)
- 2, Pvc
(size) (material)
- (6) pump 1, 8
(HP) (yield gpm)
- Elect
(type power)
- (7) electric log _____
(yes or no)
- _____ (organization running log)
- (8) how well bottom plugged
Back Wash Valve


DRILLERS REMARKS:

DEC 6 1971

MISSISSIPPI
BOARD OF
WATER COMMISSIONERS

If well telescopes please
sketch and show depths.

GROUND LEVEL

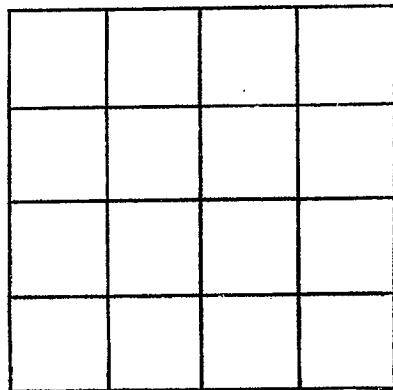

SECTION _____

Please indicate well location X.

ADDITIONAL INFORMATION

If more than one screen,
show locations of each on sketch.