

CODED

MISSISSIPPI
BOARD OF WATER COMMISSIONERS
416 North State Street
Jackson, Mississippi 39201

WATER WELL DRILLERS LOG

STONE
H 16
2-16-73

2-16-73 19 Darnell Anderson Stone
date well completed firm name county well located

LANDOWNER:

Mr. Gale Hunt
Bt A Perkinson miss
(mailing address)

description of formations encountered

from to

Top Soil 0 5
Red Clay 5 18
Sandy Clay 18 24
Fine Sand 24 36
Pink Clay 36 80
Fine Sand 80 96
Coarse Sand 96 108

WELL LOCATION:

sec 4 T 3 R 9
S W
17 miles East of Wiggins
(distance) (direction) (nearest town)

WELL PURPOSE:

Home
(home, irrigation, municipal, industrial)

WELL COMPLETION DATA:

- (1) diameter (inches) 2"
- (2) total depth (feet) 108
- (3) static water level (feet) 55 below above top of ground.
- (4) casing Plastic, 103,
(material) (depth)
5 if telescope see back.
(size)
- (5) screen 5, 103
(length) (depth to top)
2 1/2, Plastic
(size) (material)
- (6) pump 1, 8
(HP) (yield gpm)
Elect
(type power)
- (7) electric log no
(yes or no)

(organization running log)

(8) how well bottom plugged
Back Wash Valve


DRILLERS REMARKS:

CODED

MAY 25 1973

If well telescopes please sketch and show depths.

GROUND LEVEL

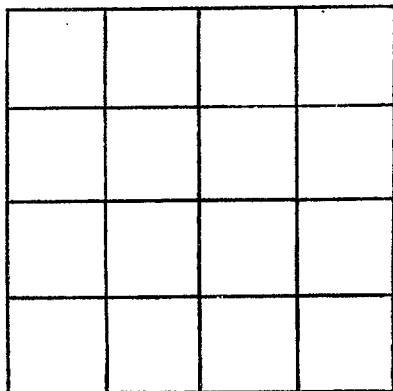

SECTION _____

Please indicate well location X.

ADDITIONAL INFORMATION

If more than one screen, show locations of each on sketch.