

STONE  
H 17  
3-12-73

MISSISSIPPI  
BOARD OF WATER COMMISSIONERS  
416 North State Street  
Jackson, Mississippi 39201  
WATER WELL DRILLERS LOG

**CODEL**

3-12 1973 PARWELL Anderson State  
date well completed firm name county well located

LANDOWNER: CARL H. GREEN  
Route 1, PERKINSTON, MISSISSIPPI  
  
(mailing address)

description of formations  
encountered

from to

WELL LOCATION:  
sec. 11 T. 3 N. R. 10 E  
S W  
9 miles EAST of PERKINSTON  
(distance) (direction) (nearest town)

Top Soil 0 4  
Red Clay 4 24  
Sho Sand 24 50  
Coars Sand 50 75

WELL PURPOSE:  
(home, irrigation, municipal, industrial)

WELL COMPLETION DATA:

- (1) diameter (inches) 2
- (2) total depth (feet) 75
- (3) static water level (feet) 35 below above top of ground.
- (4) casing plastic 70  
(material) (depth)  
  
(size) if telescope see back.
- (5) screen 5' 70  
(length) (depth to top)  
2" plastic  
(size) (material)
- (6) pump 1 7  
(HP) (yield gpm)  
Electric  
(type power)
- (7) electric log \_\_\_\_\_  
(yes or no)  
  
(organization running log)
- (8) how well bottom plugged BACKWASH VALVE


**CODED**

DRILLERS REMARKS:

MAV 25 1973  
MAY 25 1973

If well telescopes please sketch and show depths.

GROUND LEVEL

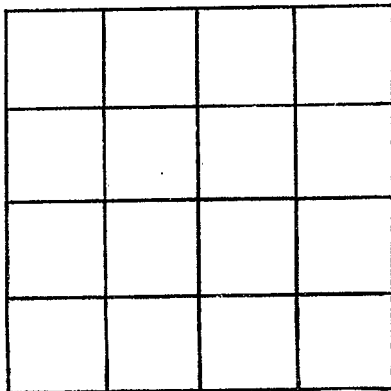

SECTION \_\_\_\_\_

Please indicate well location X.

ADDITIONAL INFORMATION

If more than one screen, show locations of each on sketch.