

STONE
H21
6-21-74

MISSISSIPPI
BOARD OF WATER COMMISSIONERS
416 North State Street
Jackson, Mississippi 39201

WATER WELL DRILLERS LOG

CODED

6-21
date well completed

1974 Pemell Anderson
firm name

Stone
county well located

LANDOWNER:

Madison Guss
Rt 1 Perkinston
(mailing address)

description of formations
encountered

description of formations encountered	from	to
<u>Top Soil</u>	<u>0</u>	<u>4</u>
<u>Red clay</u>	<u>4</u>	<u>18</u>
<u>Coarse Sand</u>	<u>18</u>	<u>74</u>

WELL LOCATION:

sec. 16 T. 3 S. R. 10 W.
8 miles E of Wegg
(distance) (direction) (nearest town)

WELL PURPOSE: HOME
(home, irrigation, municipal, industrial)

WELL COMPLETION DATA:

- (1) diameter (inches) ~~4~~ 2"
- (2) total depth (feet) 74'
- (3) static water level (feet) 9 below top of ground.
- (4) casing Plastic 69'
(material) (depth)
 if telescope see back.
(size)
- (5) screen 5' 69'
(length) (depth to top)
2" Plastic
(size) (material)
- (6) pump 1 12
(HP) (yield gpm)
E lect
(type power)
- (7) electric log no
(yes or no)

CODED

(organization running log)

(8) how well bottom plugged
Plugged

DRILLERS REMARKS:


RECORDED
INDEXED

JUL - 5 1974

MISS. BD. OF WATER COMM.

If well telescopes please sketch and show depths.

GROUND LEVEL

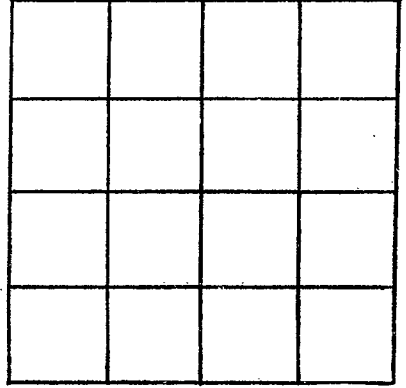

SECTION _____

Please indicate well location X.

ADDITIONAL INFORMATION

If more than one screen, show locations of each on sketch.