

STONE  
H 23  
8-13-74

MISSISSIPPI  
BOARD OF WATER COMMISSIONERS  
416 North State Street  
Jackson, Mississippi 39201

CODED

WATER WELL DRILLERS LOG

8-13 1974 Parnell Anderson Stone  
date well completed firm name county well located

LANDOWNER:  
John Mc Cormack  
Rt 1 Perkinston  
(mailing address)

description of formations encountered	from	to
<u>Top Soil</u>	<u>0</u>	<u>4</u>
<u>Red Clay</u>	<u>4</u>	<u>29</u>
<u>Sandy Clay</u>	<u>24</u>	<u>40</u>
<u>Fine Sand</u>	<u>45</u>	<u>85</u>
<u>Coarse Sand</u>	<u>85</u>	<u>125</u>

WELL LOCATION:  
sec. 29 T. 3 R. 9  
18 miles E of Perk  
(distance) (direction) (nearest town)

WELL PURPOSE: HOME  
(home, irrigation, municipal, industrial)

WELL COMPLETION DATA:

- (1) diameter (inches) 2"
- (2) total depth (feet) 125'
- (3) static water level (feet) 61' below top of ground.
- (4) casing Plastic, 120'  
(material) (depth)
- \_\_\_\_\_ if telescope see back.  
(size)
- (5) screen 5', 120'  
(length) (depth to top)
- 2", Plastic  
(size) (material)
- (6) pump 1, 8  
(HP) (yield gpm)
- Elect  
(type power)
- (7) electric log no  
(yes or no)
- \_\_\_\_\_ (organization running log)

(8) has well bottom plugged Back wash well


DRILLERS REMARKS:

RECEIVED  
SEP - 5 1974

MISS. Bd. OF WATER COMM

If well telescopes please  
sketch and show depths.

GROUND LEVEL

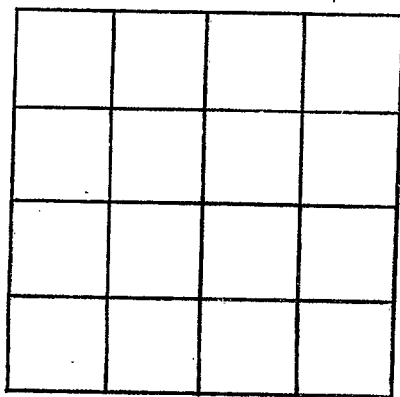

SECTION \_\_\_\_\_

Please indicate well location X.

ADDITIONAL INFORMATION

If more than one screen,  
show locations of each on sketch.