

STONE

H24

8-6-74

MISSISSIPPI
 BOARD OF WATER COMMISSIONERS
 416 North State Street
 Jackson, Mississippi 39201

WATER WELL DRILLERS LOG CODED

8-6
date well completed

1974 Danne Henderson
firm name

Stone
county well located

LANDOWNER:

Clara Sansing
Rt 1 Perkinston
(mailing address)

description of fomations encountered

	from	to
<u>Top Soil</u>	<u>0</u>	<u>4</u>
<u>white clay</u>	<u>4</u>	<u>44</u>
<u>Blue clay</u>	<u>44</u>	<u>110</u>
<u>Fine sand</u>	<u>110</u>	<u>125</u>
<u>Blue Clay</u>	<u>125</u>	<u>158</u>
<u>Coarse Sand</u>	<u>158</u>	<u>175</u>

WELL LOCATION:

sec. 7 T. 3 S. R. 9 W.
14 miles SE of Wiggins
(distance) (direction) (nearest town)

WELL PURPOSE:

HOME
(home, irrigation, municipal, industrial)

WELL COMPLETION DATA:

- (1) diameter (inches) 2"
- (2) total depth (feet) 175'
- (3) static water level (feet) 58' below top of ground.
- (4) casing Plastic, 170'
(material) (depth)
 if telescope see back.
(size)
- (5) screen 5', 170'
(length) (depth to top)
2", Plastic
(size) (material)
- (6) pump 1 (HP) 7 (yield gpm)
- Elect
(type power)
- (7) electric log no
(yes or no)
- (organization running log)

(8) how well bottom plugged Plugged


DRILLERS REMARKS:

RECEIVED
SEP - 5 1974

MISS. BD. OF WATER COMMISSIONERS

If well telescopes please sketch and show depths.

GROUND LEVEL

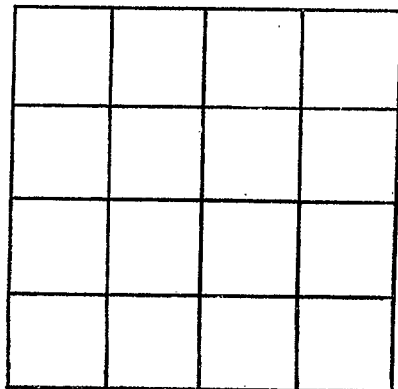

SECTION _____

Please indicate well location X.

ADDITIONAL INFORMATION

If more than one screen,
show locations of each on sketch.