

STONE
H25
10/22/74

MISSISSIPPI
BOARD OF WATER COMMISSIONERS
416 North State Street
Jackson, Mississippi 39201

CODED

WATER WELL DRILLERS LOG

16-22 1974 Parnell Anderson Stone
date well completed firm name county well located

LANDOWNER:
Wadelee Denning
(mailing address)

description of formations encountered	from	to
<u>Top Soil</u>	<u>0</u>	<u>4</u>
<u>Sandy Clay</u>	<u>4</u>	<u>18</u>
<u>White Clay</u>	<u>18</u>	<u>26</u>
<u>Blue Clay</u>	<u>26</u>	<u>35</u>
<u>Coarse Sand</u>	<u>35</u>	<u>105</u>

WELL LOCATION:
sec. 18 T. 3 R. 10
S. W. E.
7 miles SE of Wlgg.
(distance) (direction) (nearest town)

WELL PURPOSE: HOME
(home, irrigation, municipal, industrial)

WELL COMPLETION DATA:

(1) diameter (inches) 2"

(2) total depth (feet) 105'

(3) static water level (feet) 19' below top of ground.

(4) casing Plastic, 100'
(material) (depth)

(size) if telescope see back.

(5) screen 5', 100'
(length) (depth to top)

2", Plastic
(size) (material)

(6) pump 1, 10
(HP) (yield gpm)


Elect
(type power)

(7) electric log NO
(yes or no)

(organization running log)

(8) how well bottom plugged Plugged

CODED

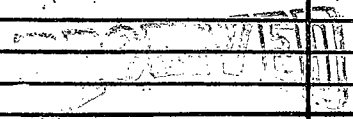


NOV 22 1974

DRILLERS REMARKS:

If well telescopes please
sketch and show depths.

GROUND LEVEL

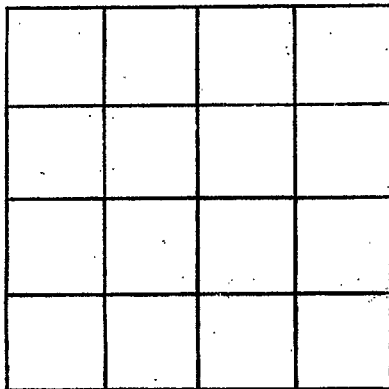

SECTION _____

Please indicate well location X.

ADDITIONAL INFORMATION

If more than one screen,
show locations of each on sketch.