

STONE
H 26
3-26-75

MISSISSIPPI
BOARD OF WATER COMMISSIONERS
416 North State Street
Jackson, Mississippi 39201

CODED

WATER WELL DRILLERS LOG

3-26 1975 Pennell Anderson Stone
date well completed firm name county well located

LANDOWNER:
Darlyn Bond
(mailing address)

description of formations encountered	from	to
<u>Top Soil</u>	<u>0</u>	<u>4</u>
<u>Red Clay</u>	<u>4</u>	<u>44</u>
<u>Coarse Sand</u>	<u>44</u>	<u>81</u>

WELL LOCATION:
sec. 29 T. 3 S. R. 9 E
14 miles E of Park
(distance) (direction) (nearest town)

CODED

WELL PURPOSE: HOME
(home, irrigation, municipal, industrial)

- WELL COMPLETION DATA:
- (1) diameter (inches) 2"
 - (2) total depth (feet) 81'
 - (3) static water level (feet) 52' below top of ground
 - (4) casing Plastic, 76' (material) (depth)
 - (size) if telescope see back.
 - (5) screen 3', 76' (length) (depth to top)
 - 2", Plastic (size) (material)
 - (6) pump 1 (HP) 10 (yield gpm)
 - Elect (type power)
 - (7) electric log no (yes or no)

(organization running log)

(8) how well bottom plugged Backwash Valve


DRILLERS REMARKS:

DECEMBER 1974

MAR 01 1975

If well telescopes please sketch and show depths.

GROUND LEVEL

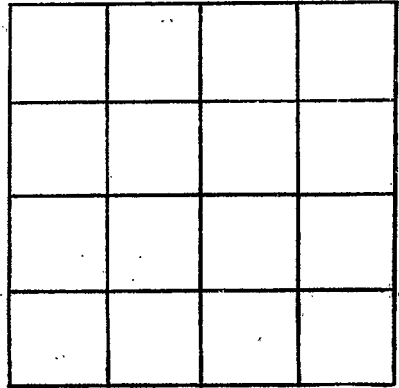

SECTION _____

Please indicate well location X.

ADDITIONAL INFORMATION

If more than one screen, show locations of each on sketch.