

Stone  
H 27  
2-22-75

MISSISSIPPI  
BOARD OF WATER COMMISSIONERS  
416 North State Street  
Jackson, Mississippi 39201

CODED 7

WATER WELL DRILLERS LOG

7-22 1975 Panell Anderson Stone  
date well completed firm name county well located

LANDOWNER:	description of formations encountered	from	to
David Mills	Top Soil	0	4
(mailing address)	white clay	4	24
WELL LOCATION:	Blue clay	24	68
sec. 32 T. 3 N. R. 9 E. 13Q	fine sand	68	85
15 miles E of Park	coarse sand	85	92
(distance) (direction) (nearest town)			
WELL PURPOSE: HOME			
(home, irrigation, municipal, industrial)			
WELL COMPLETION DATA:			
(1) diameter (inches) 8"			
(2) total depth (feet) 92'			
(3) static water level (feet) 18' below top of ground.			
(4) casing Plastic, 87' (material) (depth)			
(size) If telescope see back.			
(5) screen 5' 87' (length) (depth to top)			
2" Plastic (size) (material)			
(6) pump 1 10 (HP) (yield gpm)			
Elect (type power)			
(7) electric log no (yes or no)			
(organization running log)			
(8) how well bottom plugged Backwash valve			
DRILLERS REMARKS:			

CODED 7




AUG 4 1975

COM 1

If well telescopes please sketch and show depths.

GROUND LEVEL

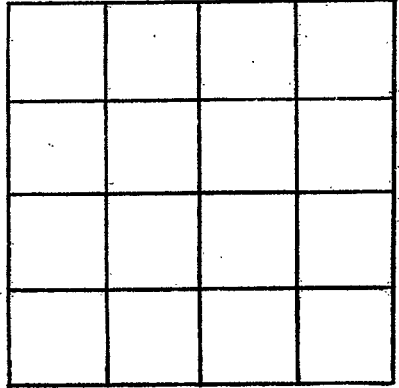

SECTION \_\_\_\_\_

Please indicate well location X.

ADDITIONAL INFORMATION

If more than one screen, show locations of each on sketch.