

Stone  
H28  
8-14-75

MISSISSIPPI  
BOARD OF WATER COMMISSIONERS  
416 North State Street  
Jackson, Mississippi 39201

CODED

WATER WELL DRILLERS LOG

8-14 1975 Pennell Anderson Stone  
date well completed firm name county well located


LANDOWNER:	description of formations encountered	from	to
<u>Tommy Bryant</u>	<u>Top Soil</u>	<u>0</u>	<u>4</u>
(mailing address)	<u>Red Clay</u>	<u>4</u>	<u>12</u>
WELL LOCATION:	<u>Coarse Sand</u>	<u>12</u>	<u>22</u>
sec. <u>9</u> T. <u>3</u> S. R. <u>9</u> W.	<u>White Clay</u>	<u>22</u>	<u>54</u>
<u>19</u> miles <u>E</u> of <u>Wiggins</u>	<u>Blue Clay</u>	<u>54</u>	<u>105</u>
(distance) (direction) (nearest town)	<u>Fine Sand</u>	<u>105</u>	<u>120</u>
WELL PURPOSE: <u>HOME</u>	<u>Blue Clay</u>	<u>180</u>	<u>315</u>
(home, irrigation, municipal, industrial)	<u>Fine Sand</u>	<u>315</u>	<u>340</u>
WELL COMPLETION DATA:	<u>Coarse Sand</u>	<u>340</u>	<u>360</u>
(1) diameter (inches) <u>2"</u>			
(2) total depth (feet) <u>360'</u>			
(3) static water level (feet) <u>30'</u> below top of ground.			
(4) casing <u>Plastic</u> <u>300'</u> (material) (depth)			
(size) If telescope see back.			
(5) screen <u>10"</u> <u>350'</u> (length) (depth to top)			
<u>7"</u> <u>Plastic</u> (size) (material)			
(6) pump <u>1</u> <u>11</u> (HP) (yield gpm)			
<u>Electric</u> (type power)			
(7) electric log <u>no</u> (yes or no)			
(organization running log)			
(8) how well bottom plugged <u>Backwash valve</u>			
DRILLERS REMARKS:			

RECEIVED

SEP - 4 1975

If well telescopes please sketch and show depths.

GROUND LEVEL

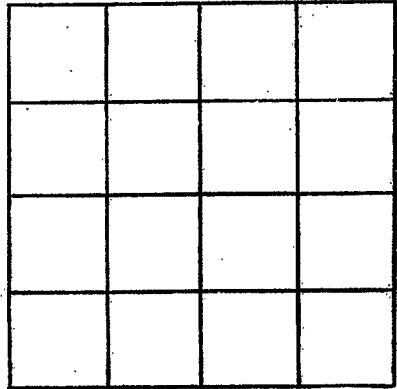

SECTION \_\_\_\_\_

Please indicate well location X.

ADDITIONAL INFORMATION

If more than one screen, show locations of each on sketch.