

MISSISSIPPI DEPARTMENT OF NATURAL RESOURCES

Bureau of Land and Water Resources

Southport Mall

P.O. Box 10631

CODED

Jackson, Mississippi 39209

WATER WELL DRILLERS LOG

STONE
H29

9-15 date well completed 1984 Frank Puccio firm name Stone county well located

LANDOWNER: Forest Benley
 (mailing address)

description of formations encountered	from	to
<u>Top soil</u>	<u>0</u>	<u>3</u>
<u>Clay</u>	<u>3</u>	<u>12</u>
<u>Fin Sand</u>	<u>12</u>	<u>70</u>
<u>Coarse Sand</u>	<u>70</u>	<u>82</u>

WELL LOCATION:
 sec. 7 T. 3^N R. 10^E
2 1/2 miles E of Big Level
 (distance) (direction) (nearest town)

WELL PURPOSE: HOME
 (home, irrigation, municipal, industrial)

CODED

WELL COMPLETION DATA:

(1) diameter (inches) 2"

(2) total depth (feet) 82'

(3) static water level (feet) 18' ^{below}/_{above} top of ground.

(4) casing PVC, 77',
 (material) (depth)

(size) if telescope see back.

(5) screen 5', 79'
 (length) (depth to top)

(size) (material)
1/2" PVC

(6) pump 1/2 8
 (HP) (yield gpm)

Elect
 (type power)

(7) electric log no
 (yes or no)

(organization running log)


(8) how well bottom plugged DNV

MISSISSIPPI DEPARTMENT OF NATURAL RESOURCES
 BUREAU OF LAND & WATER RESOURCES
 NOV 5 1984
 RECEIVED

DRILLERS REMARKS:

If well telescopes please sketch and show depths.

GROUND LEVEL

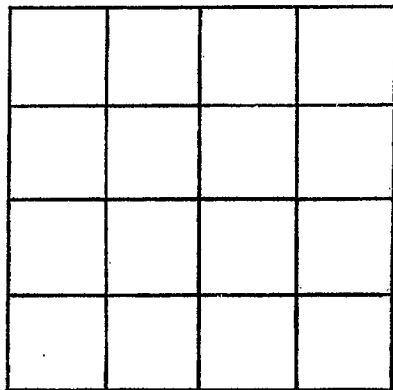

SECTION _____

Please indicate well location X.

ADDITIONAL INFORMATION

If more than one screen, show locations of each on sketch.