

MISSISSIPPI DEPARTMENT OF NATURAL RESOURCES

Bureau of Land and Water Resources

Southport Mall

P.O. Box 10631

Jackson, Mississippi 39209

CODED

WATER WELL DRILLERS LOG

STONE
H30

9-25-84 date well completed 1984 Frank Price firm name Stone county well located

LANDOWNER:
Mark Bryant
(mailing address)

description of formations encountered	from	to
Top soil	0	2
Sandy Clay	2	28
Hard Sand	28	50
Coarse Sand	50	63

WELL LOCATION:
sec. 29 T. 3 S. R. 9 E
2 miles S of Bimble Springs (distance) (direction) (nearest town)

WELL PURPOSE: HOME
(home, irrigation, municipal, industrial)

CODED

- WELL COMPLETION DATA:
- (1) diameter (inches) 2"
 - (2) total depth (feet) 63'
 - (3) static water level (feet) 35' below top of ground.
 - (4) casing PVC, 58' (material) (depth)
 - (5) screen 5' length, 58' depth to top, 2" size, PVC material.
 - (6) pump 1/2 HP, 9 yield gpm, Elect type power.
 - (7) electric log no
 - (8) how well bottom plugged B W V

DEPT. OF NATURAL RESOURCES
BUREAU OF LAND & WATER RESOURCES


NOV 5 1984

RECEIVED

DRILLERS REMARKS:

If well telescopes please
sketch and show depths.

GROUND LEVEL

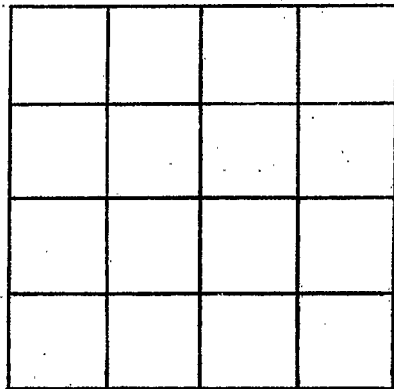

SECTION _____

Please indicate well location X.

ADDITIONAL INFORMATION

Lined area for providing additional information, consisting of 20 horizontal lines.

If more than one screen,
show locations of each on sketch.