
State W	ell Report		
Close P	art 1	For Office Use Only:	
County: Stope Mississippi Departmen	Mississippi Department of Environmental Quality		
Permit #: Office of Land a	Office of Land and Water Resources		
	Box 10631	Well #: <u>H-55</u>	
Jackson, N	IS 39289-0631 961-5210	L. S. Elevation:	
(601) (601) (601)	4-6938 (fax)	E-log #:	
State Law requires that this report be prepared by the driller in detail and filed with the Department within 30 days of completion of drilling of the well.			
Well Owner Information	Wel	Location 55	
Owner Name Randy + Karri CUEVAS	Latitude: 30 • 44 , 45	Location 55 " Longitude 088 56 , 907"	
Mailing Address: Cable, Bridge, Rd	Method of Lat/Long (circle or	ne): Conventional Survey,	
	USGS quad, Hand-held	GPS_Survey-grade GPS	
Perkinston MS 39573	AW 1/4 SEV 1/4 Sec 36	Twn T35 Rng RIOW	
City State Zip Code	Distance Direction	Nearest Town	
Telephone No. (208) 669 - 1598	Distance Direction	of Perkinston	
Well Data			
Purpose of Well (circle one Home Industrial Public Supply Irrigation Fish Culture Other:			
Date well drilling started: Date well drilling completed:			
If flowing, method of flow regulation: Valve N/A Other (describe)			
Static Water Level: 45 feet above or below circle one)			
Method of Measurement (circle one) steel tape electric tape air line other:			
Hole depth: 105' Well depth: 105' Well grouted to a depth of 10feet			
Type of grout (circle one): Cement Bentonite Mix			
Casing length: <u>95</u> feet Casing diameter: <u>a</u> inches Type of casing: <u>PUC</u>			
Screen length: <u>10</u> feet Screen diameter: <u>2</u> inches Type of screen: <u>PUC</u>			
Screen slot size:OOinches Setting depth: Fromfeet tofeet tofeet			
Type of completion (circle all applicable): Gravel packed Underreamed Telescoped Open hole Natural Development			
Other (describe):			
Top of lap pipe or reduction in casing:feet. If telescoped or more than one screen, describe on back of page			
Logs run (circle all applicable): No log run Electric Gamma Ray	Density Sonic Neutron	Other:	
Name of organization running log(s): N//A		······································	
I certify that the well was drilled, constructed, and completed in accordance with all applicable requirements of the Mississippi			
Department of Environmental Quality and/or the Mississippi Department of Health regulations and state laws.			
Jack Ridgdell 0-472	ah,	Refidence	
Print Name of Water Well Contractor and License No.	Signature of		

JUN 27 2005 BY: OLWR If well telescopes please sketch below and show depths.

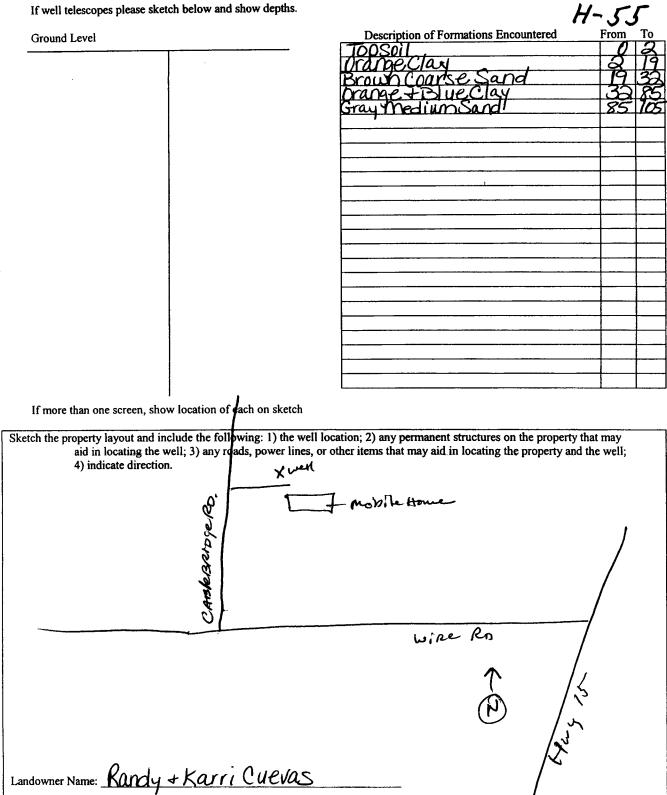

Signature of Water Well Contractor

RECEIVED JUN 27 2005 **BY: OLWR** 

STATE WELL REPORT		
Permit #: Driller: Oast Water Well Sev Date completed: 0-4-05	Part 2  For Office Use Only:    Mer's Completion Report  Aquifer:    Mer of Environmental Quality  Aquifer:    Mathematical Advances  Well #:    Mathematical Advances  Well #:    Mathematical Advances  Elevation:	
This report should be prepared by the pump installer in detail and filed with the Department within 30 days of the installation of pump.		
Well Owner Information Owner Name: RANdy +Karri Cuevas Mailing Address: Cable Bridge RD Rerkinston MS 39573 City State Zip Code Telephone No. OBS 669 - 1598	Well Location    Latitude: 30° 44 '434 Longitude: 088° 56' 907"    Method of Lat/Long (circle one): Conventional Survey,    USGS quad, Hand-held GPS, Survey-grade GPS    SE 14 SE 14 Sec 26 Twn 735 Rng R10 W    Distance  Direction    Nearest Town	
Pump Type	<u>II Miles ESE of PERKINSTON</u> Power Type	
Circle one	Circle one	
Air Lift Jet Submersible	Diesel Engine Gasoline Engine Natural Gas	
Bucket Piston Turbine	Electric Motor Hand Tractor PTO	
Centrifugal  Rotary  Flowing Well    Other (specify):  149    Date Pump Installed:  10-(0-0.5)    Rated Pump Capacity:  8    Gallons Per Minute	Windmill  Other (specify):    Horse Power Rating of Motor: / HP Go ulds    Setting Depth:     Setting Depth:     Number of Stages:	
Pump Test Data	Method of Measuring Water Level	
Date Well Tested: $6-6-05$ Static Water Level (A): $45$ Feet Below Land Surface Pumping Water Level (B): $N/A$ Feet Below Land Surface Drawdown [(B) – (A)]: $N/H$ Feet Below Land Surface Test Pumping Rate: $8$ Gallons Per Minute Duration of Pump Test (minimum 4 hours): $5$ hours	Circle one Air Line Electric Measuring Line Steel Tape Other (specify): For flowing well, measured shut in head: $N/A$ feet Well yielded $S$ GPM with a drawdown of N/A feet after $N/A$ hours of pumping	
I HEREBY CERTIFY that the above statements are true to the best of my knowledge. Ben Ridgdell 0-713P Print Name of Pump Installer and License No. (if applicable) Signature of Pump Installer RECEIVE		

· · ·

JUN 27 2005 BY: OLWR