

State Well Report

Part 1

Mississippi Department of Environmental Quality
Office of Land and Water Resources
P.O. Box 10631
Jackson, MS 39289-0631
(601)961-5210
(601)354-6938 (fax)

For Office Use Only:

Aquifer: _____
Well #: H-61
L. S. Elevation: _____
E-log #: _____

County: Stone

Permit #: _____

Driller: Coast Water Well Serv.

Date drilling completed: 3-13-06

State Law requires that this report be prepared by the driller in detail and filed with the Department within 30 days of completion of drilling of the well.

Well Owner Information

Owner Name: Brentley Dunn

Mailing Address: 282 New Zion Rd.

Perkinston Ms 39570
City State Zip Code

Telephone No. (601) 928-9497

Well Location

Latitude: 30° 48' 616" Longitude: 088° 54' 538"
40 32

Method of Lat/Long (circle one): Conventional Survey,

USGS quad, (Hand-held GPS) Survey-grade GPS

NE 1/4 NE 1/4 Sec 8 Twn T35 Rng R9W

Distance Direction Nearest Town
1.4 Miles SE of Wiggins

Well Data

Purpose of Well (circle one) Home Industrial Public Supply Irrigation Fish Culture Other: _____

Date well drilling started: 3-13-06 Date well drilling completed: 3-13-06

If flowing, method of flow regulation: Valve N/A Other (describe) _____

Static Water Level: 21 feet above or below (circle one) land surface Date measured: 3-13-06

Method of Measurement (circle one) steel tape electric tape air line other: _____

Hole depth: 26' Well depth: 26' Well grouted to a depth of 10 feet

Type of grout (circle one): Cement Bentonite Mix

Casing length: 21 feet Casing diameter: 2 inches Type of casing: PVC

Screen length: 5 feet Screen diameter: 2 inches Type of screen: PVC

Screen slot size: 0.88 inches Setting depth: From 21 feet to 26 feet

Type of completion (circle all applicable): Gravel packed Underreamed Telescoped Open hole Natural Development

Other (describe): _____

Top of lap pipe or reduction in casing: N/A feet. If telescoped or more than one screen, describe on back of page

Logs run (circle all applicable): No log run Electric Gamma Ray Density Sonic Neutron Other: _____

Name of organization running log(s): N/A

I certify that the well was drilled, constructed, and completed in accordance with all applicable requirements of the Mississippi Department of Environmental Quality and/or the Mississippi Department of Health regulations and state laws.

Jack Ridgell 0-472

Print Name of Water Well Contractor and License No.

Jack Ridgell
Signature of Water Well Contractor

RECEIVED


APR 10 2006

BY: OLWR

H-61

If well telescopes please sketch below and show depths.

Ground Level

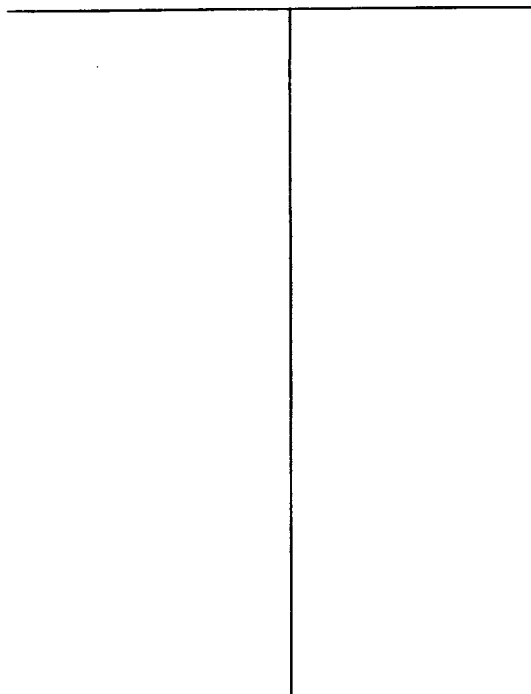

Description of Formations Encountered	From	To
TOP SOIL	0	2
BROWN CLAY	2	13
White coarse sand	13	21

If more than one screen, show location of each on sketch

Sketch the property layout and include the following: 1) the well location; 2) any permanent structures on the property that may aid in locating the well; 3) any roads, power lines, or other items that may aid in locating the property and the well; 4) indicate direction.

Landowner Name: Brentley Dunn

Jack Rydzell
Signature of Water Well Contractor

RECEIVED
APR 10 2006
BY: OLWR

STATE WELL REPORT

Part 2

Pump Installer's Completion Report
 Mississippi Department of Environmental Quality
 Office of Land and Water Resources
 P.O. Box 10631
 Jackson, MS 39289-0631
 (601)961-5210
 (601)354-6938 (fax)

County: Stone
 Permit #: _____
 Driller: Coast Water Wells SRV.
 Date completed: 3-13-06

For Office Use Only:

Aquifer: _____
 Well #: H-61
 Elevation: _____

This report should be prepared by the pump installer in detail and filed with the Department within 30 days of the installation of pump.

Well Owner Information	Well Location
Owner Name: <u>Brentley Dunn</u>	Latitude: <u>30° 48' 676"</u> Longitude: <u>088° 54' 538"</u>
Mailing Address: <u>282 New Zion Rd.</u>	Method of Lat/Long (circle one): Conventional Survey, <u>40</u>
<u>Perkinston Ms 39570</u>	USGS quad, <u>(Hand-held GPS)</u> Survey-grade GPS
City State Zip Code	<u>NE 1/4 NE 1/4 Sec 8 Twn 73S Rng R9W</u>
Telephone No. <u>606 928-9497</u>	Distance Direction Nearest Town
	<u>14</u> Miles <u>SE</u> of <u>Wiggins</u>

Pump Type Circle one	Power Type Circle one
Air Lift <input type="radio"/> Jet <input checked="" type="radio"/> Submersible	Diesel Engine Gasoline Engine Natural Gas
Bucket <input type="radio"/> Piston <input type="radio"/> Turbine	<u>Electric Motor</u> Hand Tractor PTO
Centrifugal <input type="radio"/> Rotary <input type="radio"/> Flowing Well	Windmill Other (specify): _____
Other (specify): _____	Horse Power Rating of Motor: <u>1 HP Gouldo Pump</u>
Date Pump Installed: <u>3-17-06</u>	Setting Depth: <u>18FT Drop pipe</u> feet
Rated Pump Capacity: <u>7</u> Gallons Per Minute	Number of Stages: <u>2</u>

Pump Test Data	Method of Measuring Water Level Circle one
Date Well Tested: <u>3-17-06</u>	<u>Air Line</u> Electric Measuring Line Steel Tape
Static Water Level (A): <u>20</u> Feet Below Land Surface	Other (specify): _____
Pumping Water Level (B): <u>N/A</u> Feet Below Land Surface	For flowing well, measured shut in head: <u>N/A</u> feet
Drawdown [(B) - (A)]: <u>N/A</u> Feet Below Land Surface	Well yielded <u>7</u> GPM with a drawdown of
Test Pumping Rate: <u>7</u> Gallons Per Minute	<u>N/A</u> feet after <u>N/A</u> hours of pumping
Duration of Pump Test (minimum 4 hours): <u>4</u> hours	

I HEREBY CERTIFY that the above statements are true to the best of my knowledge.

Ben Ridgell 0-713P Ben Ridgell
 Print Name of Pump Installer and License No. (if applicable) Signature of Pump Installer

RECEIVED
 APR 10 2006
 BY: OLWR