## STATE WELL REPORT

## County: Stone Permit #: Driller: Scott Boone Date drilling completed: 07/16/2021

## Part 1 Driller's Log

Mississippi Department of Environmental Quality
Office of Land and Water Resources
P.O. Box 2309
Jackson, MS 39225-2309
(601)961-5555

For Office Use Only:
Well #: <u>H86</u>
Aquifer:
E-Log #:

(601)961-5228 (fax)

State Law requires that this report be prepared by the license holder responsible for the work and filed with the Department at the above address within 30 days of completion of drilling of the well or borehole.

Well Owner Information			
(Landowner if borehole is not for a water well)	Latitude: 30.7531400 Longitude:	-88.9062490	
Owner Name: Kristy rushing	Mathadatiatian ( )	antiqual Comme	
Mailing Address: 57 vestry rd	Method of Lat/Long (check one): Conv	·	
	USGS quad, Hand-held GPS,	Survey-grade GPS	
Perk Ms 39577	<u>SW_</u> 1/4_ <u>SE</u> _1/4, Sec <u>29</u>	$T \phantom{00000000000000000000000000000000000$	
City State Zip Code	8 miles Miles West of Luc	edale	
Telephone No. (228) 860-2672	(Distance) (Direction)		
- Wall / B	Parabala Data		
Date drilling started: 07/16/2021 Date drilling completed:		e diameter: <u>7-1/4</u>	
Location of the source of any surface water used for drilli			
Method of dosing and volume of Chlorine used in drilling a	<sub>nd development:</sub> Granular		
Logs run (check all applicable): No log run⊡Electric Gamı		er:	
Name of organization running log(s):			
Purpose of borehole (check one): Water Well 🗹 Geotechn	ical/Geological Investigation Ground S	Source Heat Pump	
Seismic Survey Other	(describe)		
If drilling is not related to water well c	onstruction, skip the remainder of this i	block	
Purpose of Well (check all applicable): Home Industrial Public Supply Irrigation Fish Culture			
Other (describe):			
If a flowing well, method of flow regulation: Valve	Other (describe)		
Static Water Level: 55feet [ above or []below] land surface Date measured: 07/16/2021 (check one)			
Method of measurement (check one): Steel tape Electric	tane Air line Other (describe):		
Well depth: 85 Well grouted to a depth of: 10 feet Type of grout (check one) Neat Cement Bentonite Mix			
Casing length: 75feet Casing diameter: 4inches Type of casing: PVC			
Screen length: 10 feet Screen diameter: 4 inches Type of screen: PVC			
Screen slot size: <u>.08</u> inches Setting depth:	From <u>75</u> feet to <u>85</u>	feet	
Type of completion (check all applicable): Gravel packed	Underreamed Open hole Natu	ıral Development	
Other (describe):		RECEIVED	
Top of lap pipe or reduction in casing:feet			
If telescoped or more than	one screen describe on next nage	07-23-2021	

County:	Stone
Permit #:	

RECEIVED
07-23-2021
By OLWR

Fo	or Office Use Only:
Well #: _	H86
_	

The sketch below only required for water wells


If well telescopes, show depths on sketch.

Ground Level		
--------------	--	--

Description of formations encountered must be provided for all wells and boreholes, unless specifically exempted by regulations

Description of Formations Encountered	From (depth) Ground level	To (depth)
Orange sandy clay	Ground level	10
Chorus sand	10	85

If more than one screen, show location of each on sketch

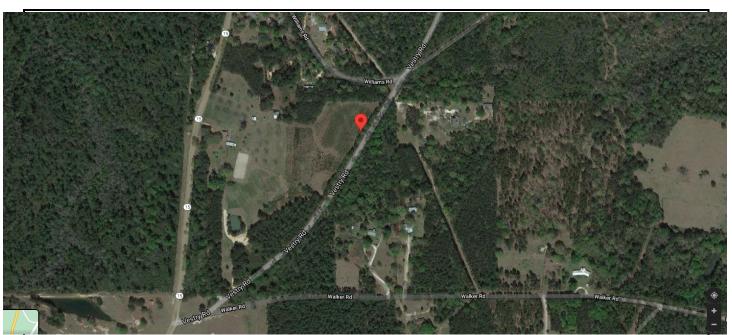

Landowner Name: Kristy rushing

I HEREBY CERTIFY that the well/borehole was drilled, constructed, and completed in accordance with all applicable requirements of the Mississippi Department of Environmental Quality and the Mississippi Department of Health regulations, if applicable, and state laws.

Scott Boone 6262 Print Name of Responsible Licensee and License No.

07/19/2021 Date

Scott Boone

Signature of Licensee

Form: OLWR-SWR-1B (4/13)