

Stone
H2000
3-19-76

MISSISSIPPI
BOARD OF WATER COMMISSIONERS
416 North State Street
132 Jackson, Mississippi 39201

WATER WELL DRILLERS LOG

3-19 1976 *Danell Anderson* Stone
date well completed firm name county well located

LANDOWNER:
Jed Hooks

(mailing address)

description of formations encountered	from	to
<i>Top Soil</i>	<i>0</i>	<i>4</i>
<i>Red Clay</i>	<i>4</i>	<i>18</i>
<i>Fine Sand</i>	<i>18</i>	<i>77</i>
<i>Coarse Sand</i>	<i>77</i>	<i>85</i>

WELL LOCATION:
sec *29* T *3* R *9* E
S W
15 miles *SE* of *Wiggins*
(distance) (direction) (nearest town)

WELL PURPOSE: *HOME*
(home, irrigation, municipal, industrial)

WELL COMPLETION DATA:

(1) diameter (inches) *2"*

(2) total depth (feet) *85'*

(3) static water level (feet) *39'* below top of ground.

(4) casing *Plastic* *80'*
(material) (depth)

(size) if telescope see back.

(5) screen *5"* *80'*
(length) (depth to top)

2" *Plastic*
(size) (material)

(6) pump *1* *70*
(HP) (yield gpm)


Elect
(type power)

(7) electric log *no*
(yes or no)

(organization running log)


(8) how well bottom plugged *Plugged*

DRILLERS REMARKS:

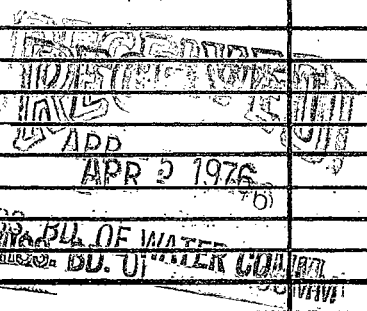

If well telescopes please sketch and show depths.

GROUND LEVEL

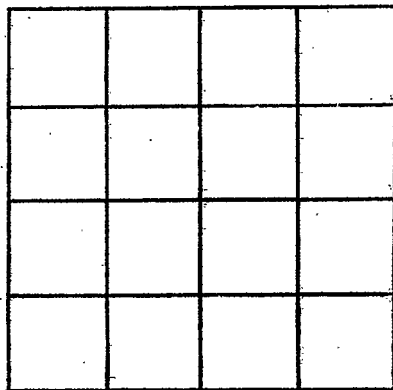

SECTION _____

Please indicate well location X.

ADDITIONAL INFORMATION

If more than one screen, show locations of each on sketch.